C.S. File No. [illegible]/49 – 2

COUNTY SURVEYORS FILE DATA
DO NOT REMOVE FROM OFFICE

SURVEY ADDENDUM to RECORDED SURVEY in FILE {C.S. 58/125, M69-3}

Sec. 23, T. 32S., R. 6W., W.M.
Douglas County, Oregon

RECEIVED
AUG 21 1978
COUNTY SURVEYOR
DOUGLAS COUNTY, ORE.

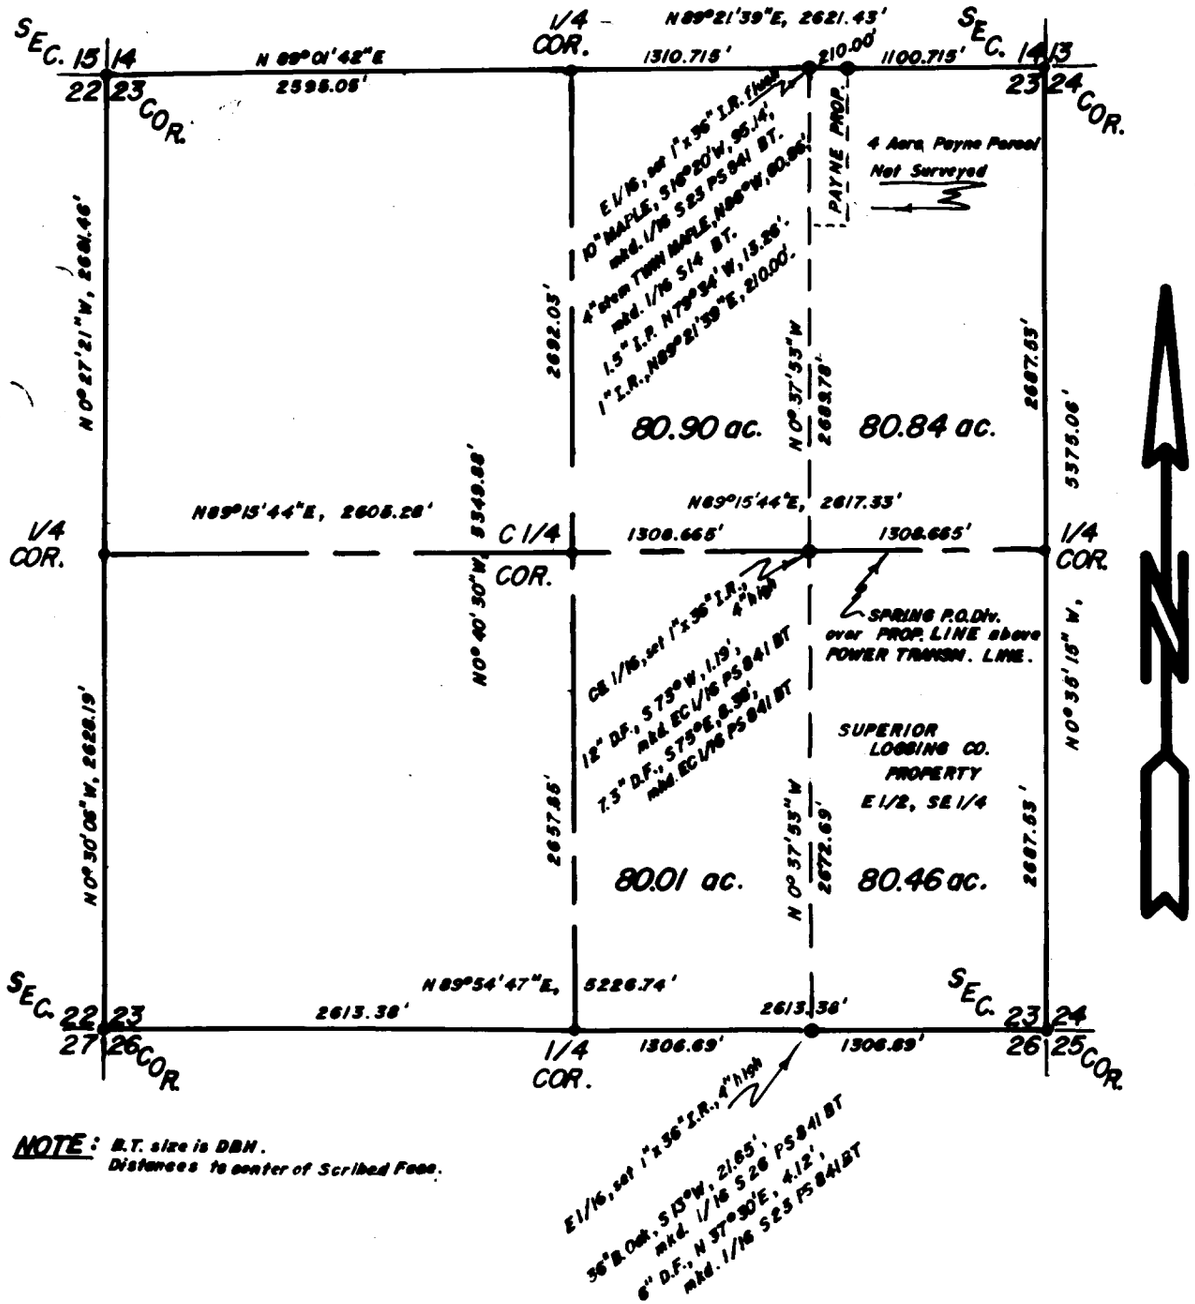

NOTE: B.T. size is DBH.
Distances to center of Scribed Face.

Survey For:

J.W. Payne, Glendale, Ore. and Superior Logging Co., Glendale, Ore.

Survey By:

Ronald A. Brandt, P.S. 841
Glendale, Ore. 97442

DATE: Aug. 20, 1978

SCALE: 1 inch = 1000 feet

REGISTERED PROFESSIONAL LAND SURVEYOR
Ronald A. Brandt
OREGON
JULY 12, 1968
RONALD A. BRANDT
841

MONUMENTS:

As per C.S. 58/125 & M69-3 - - - - - •

Set 1" x 36" I. Rods - - - - - - - - - •