Prepared for

~ Clarence Lousignont ~

Showing

Lots 3 + 4, Block 5, Goodell Tract, Canyonville, Oregon

Scale 1" = 20' August, 1977

T.30-5 S.E. N.W. Sec. 34

COUNTY SURVEYORS FILE COPY
DO NOT REMOVE FROM OFFICE

FILED
RECEIVED
AUG 29 1977
COUNTY SURVEYOR
DOUGLAS COUNTY, ORE.

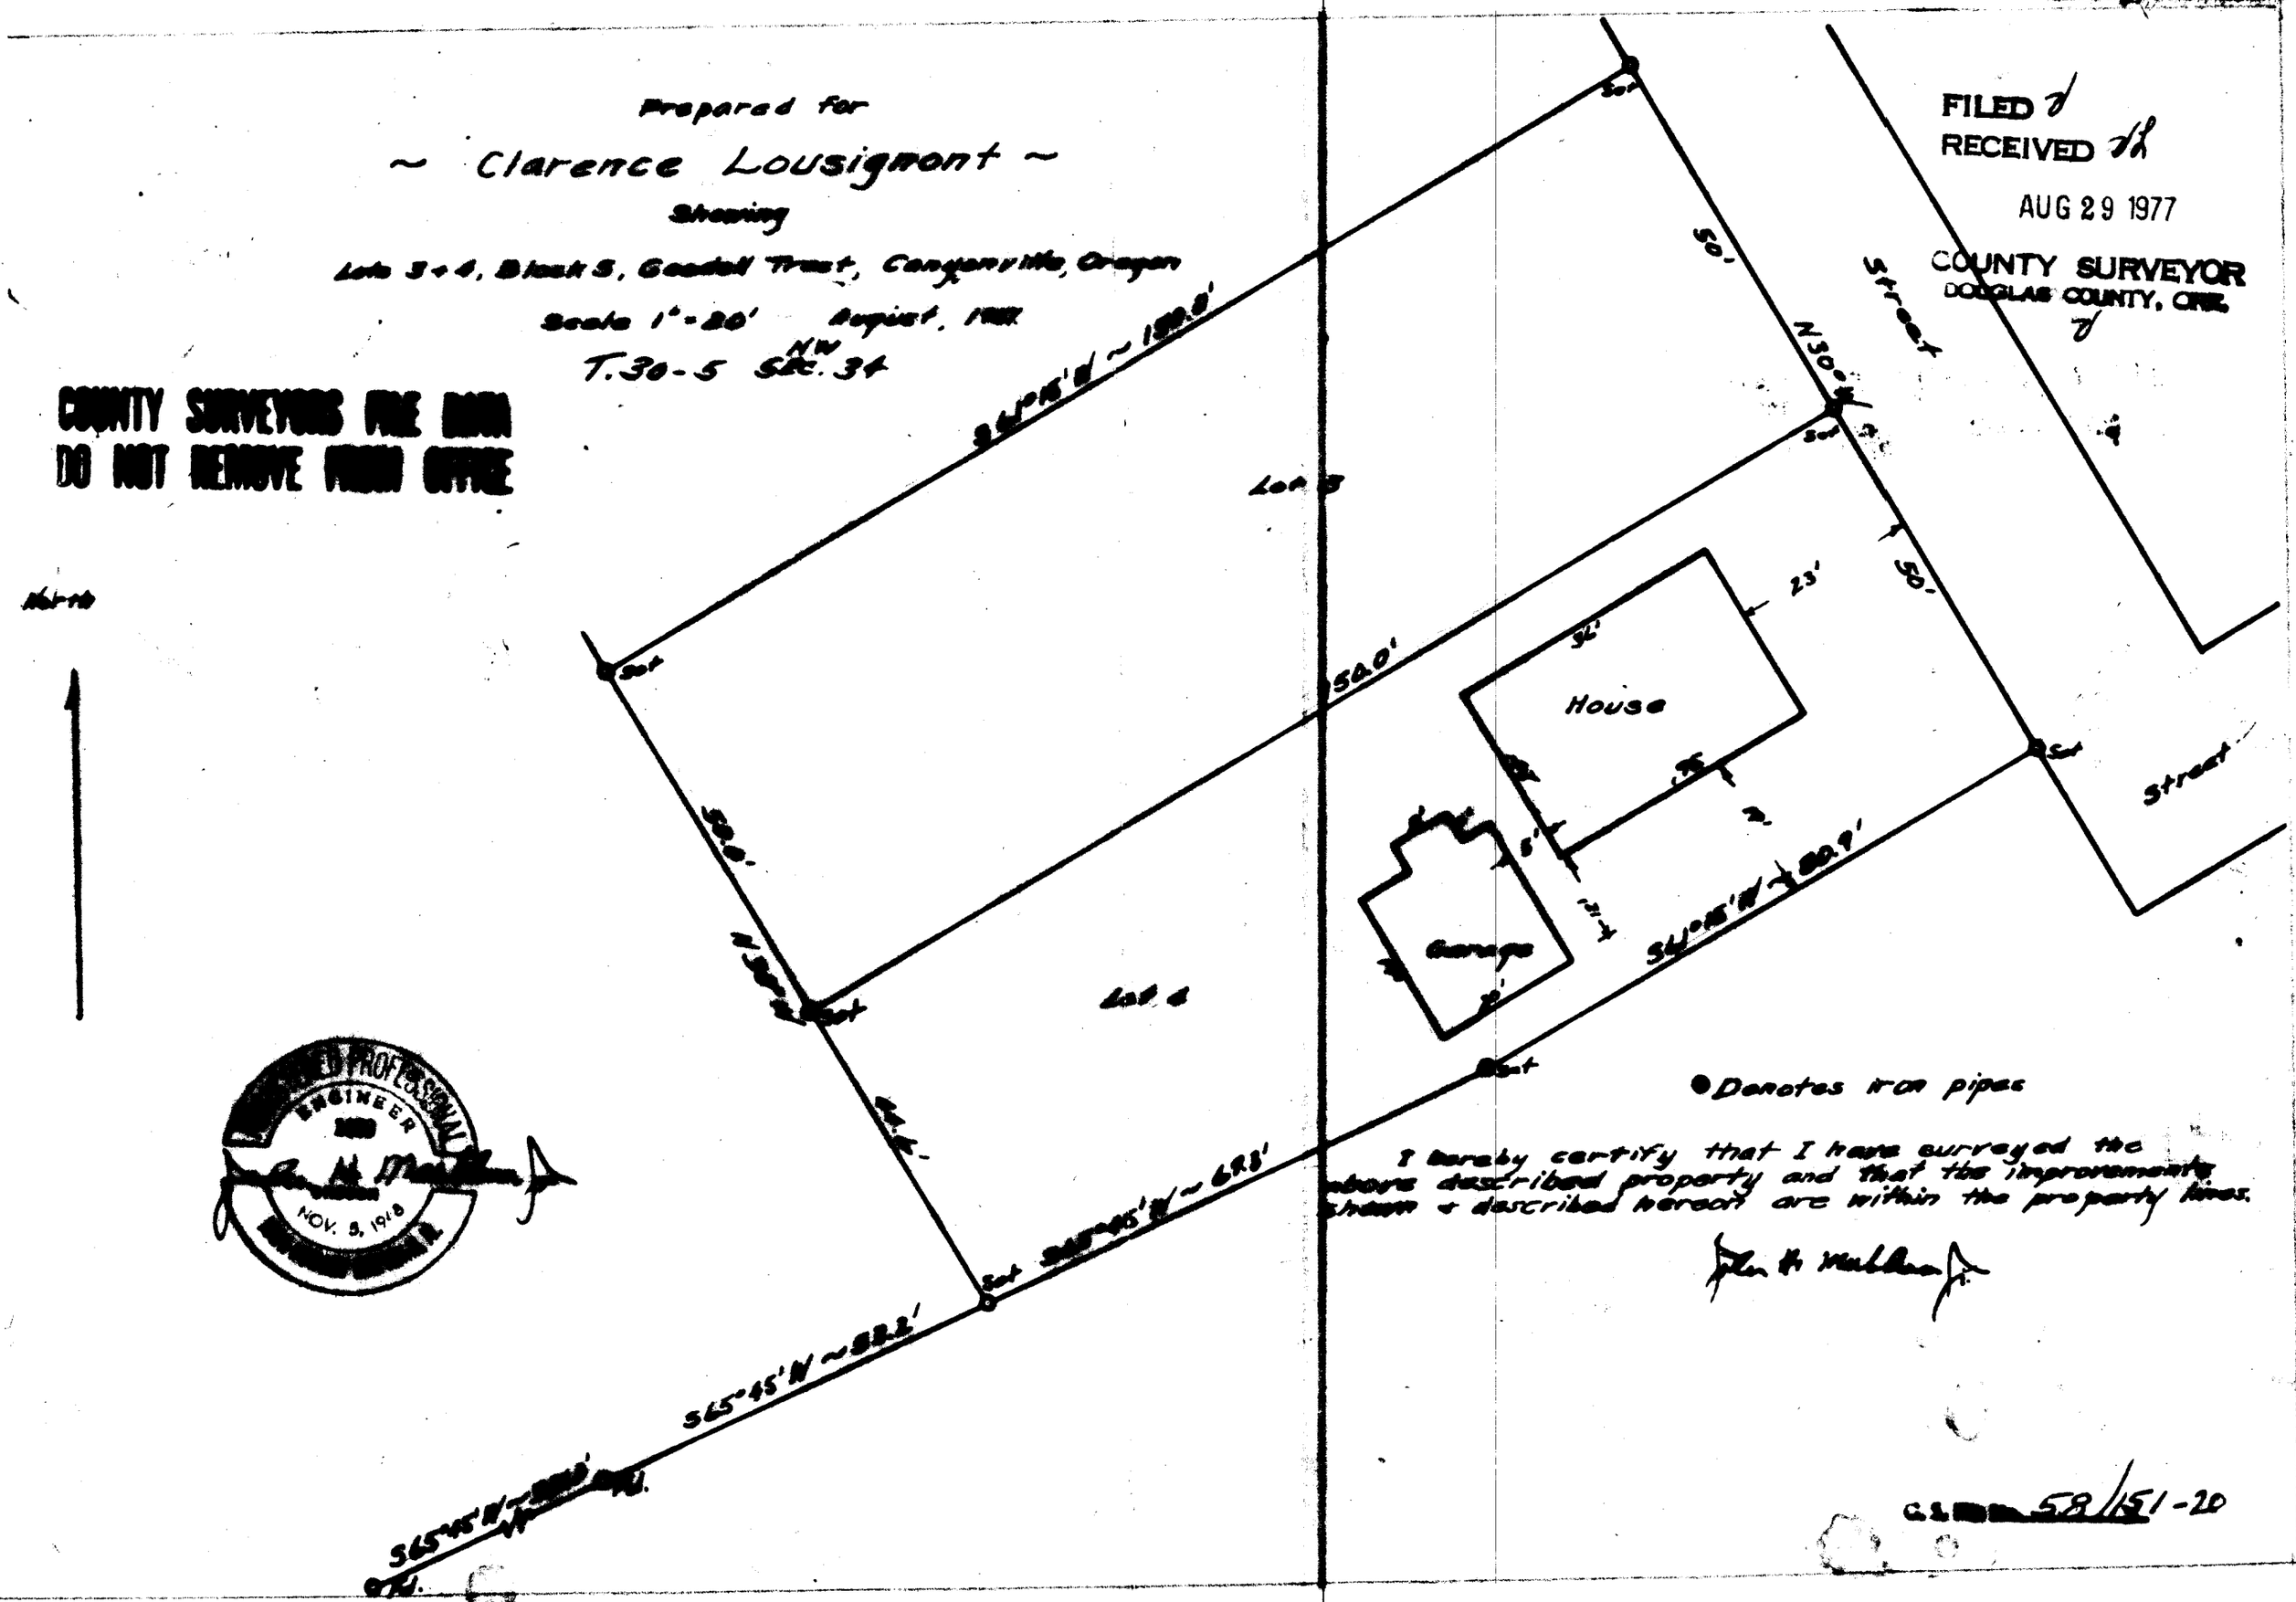

I hereby certify that I have surveyed the above described property and that the improvements shown + described hereon are within the property lines.

CS 58/151-20