SURVEY IN LOT 1, BLOCK 1, "HOUSLEY HEIGHTS" PLAT 1
SECTION 12, T27S, R6W, W.M.

FOR: WENDYS HAMBURGER
BY: B.H.W. ENG. & SURVEYING
FEB. 1978
SCALE 1" = 40'

COUNTY SURVEYORS FILE DATA
DO NOT REMOVE FROM OFFICE

FILED
RECEIVED
FEB 21 1978
COUNTY SURVEYOR
DOUGLAS COUNTY, ORE.

REGISTERED PROFESSIONAL LAND SURVEYOR
Romanso E. Ware
OREGON
NOV. 16, 1978
ROMANSO E. WARE
1005

• ——— FD. MONUMENT
○ ——— SET MONUMENT

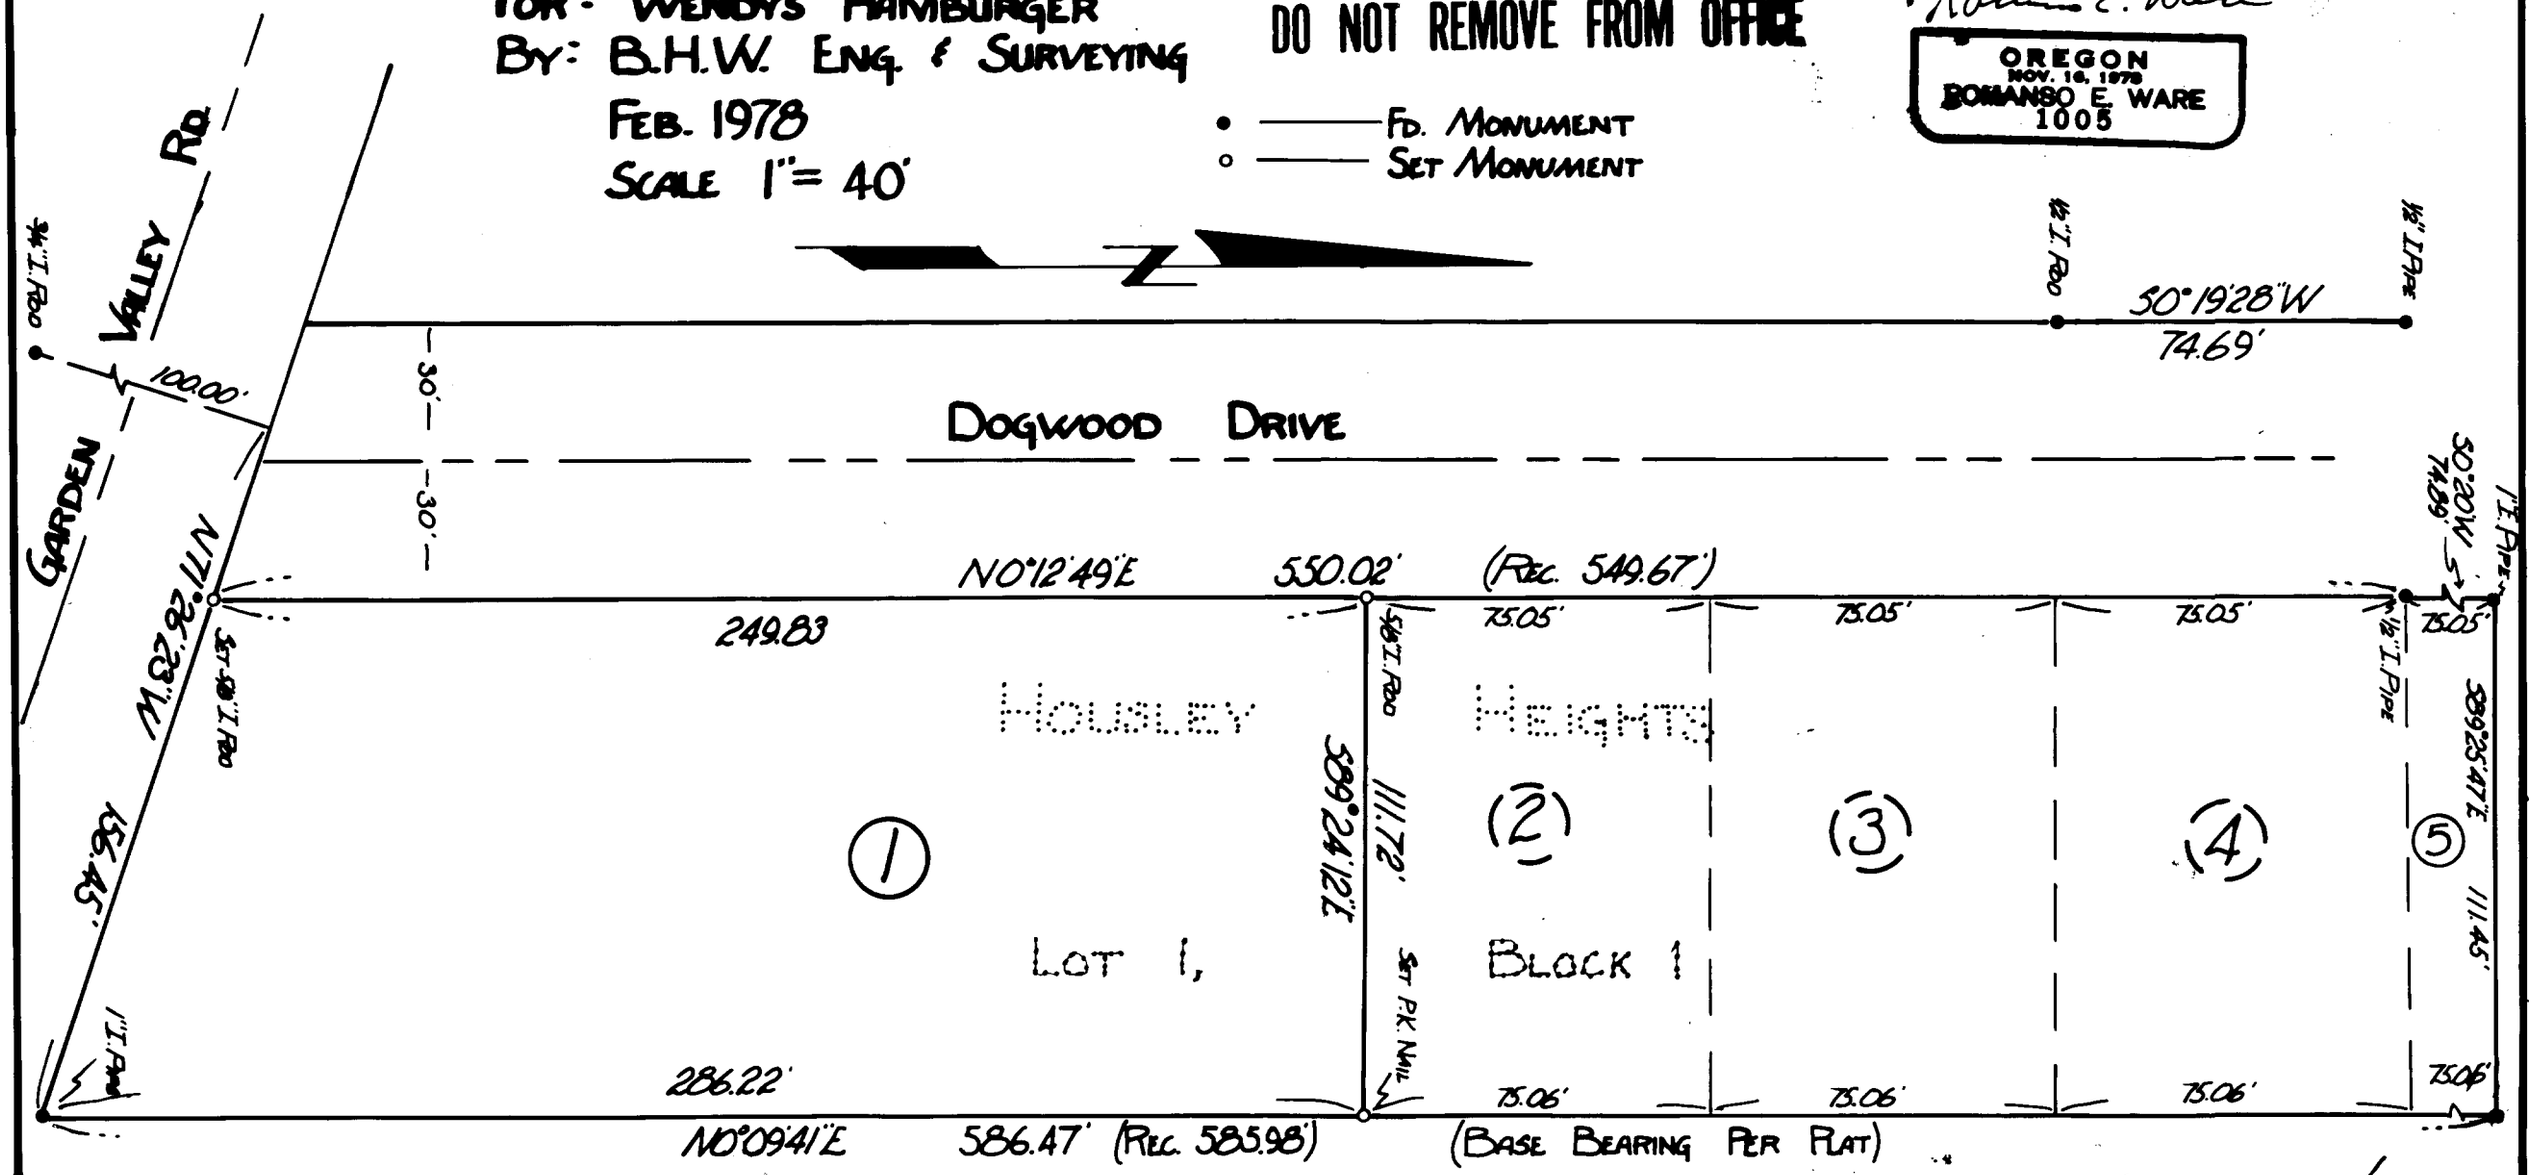

C.S. File No. 58/160 - 4