

T 19-10

28 | 27  
---  
33 | 34

DATE: July 12, 1977

- Condition Report Only
- Not Found
- Renewed
- Unrecorded
- Surveyed In
- Referenced Out

Previous Renewal #'s 53/66 (10)

Monument(s) Found: (Condition and Source) BRASS CAP MKD.  
county surveyors office, 1968. ORIGINAL  
corner Tree stump (Reverse scribing visible).  
Good condition

Accessories Found: (Condition and Source)

- 12" Orig. D-Fir snag bvs. N30°E Dist. 12<sup>±</sup> <sup>scribing</sup> visible
- 18" D-Fir bvs. N86°E, Dist. 27<sup>±</sup> Healed Face
- 37" D-Fir bvs. S65°E, Dist. 47<sup>±</sup> Healed Face
- 39" orig. D-Fir bvs. S51°W, Dist. 12<sup>±</sup> <sup>Healed Face</sup> + old chopped-out Face.
- 23" D-Fir bvs. N71°W, Dist. 13<sup>±</sup> Healed Face
- 20" orig. D-Fir snag bvs. N39W, Dist 10<sup>L</sup> chopped-out face

v.r.

C. ... 50/62-2A

RENEWAL

Monument Set: (Procedure and Description) \_\_\_\_\_

NONE

New Accessories: (Description) \_\_\_\_\_

NONE

Location and Comments:

Beginning at Location  
Poster on USFS  
Road # 1988, 90  
West 930 ft. to  
corner.

20°

U.S. Forest Service  
Ernesto R. ALVARADO  
TIM MACE  
Gordon H. Long  
PAT BAYNES

Compass Declination

Agency

Party Chief

Notekeeper

Witnesses

CS 58/162-26

New Bearing Trees

46" Douglas-fir bears N22°W, Distance 35<sup>31</sup> ft.  
Double faced scribed 1/4 S27, and BT

22" maple bears S84°E, Distance 30<sup>88</sup> ft.  
Double faced scribed 1/4 S34, and BT

Thence S89° 49' 44" W, begin new bearing,  
along south boundary of Section 27.

Top of spur, bears S, descend.

Creek 15 feet wide, course SW; ascend.


Top of spur, bears S. descend.

West edge of USFS Road # 1908 bears NE & SW

Creek 15 feet wide, course SE; ascend.

The corner to Section 27, 28, 33 and 34 found; original  
corner tree stump, reverse scribing visible; Brass cap  
marked County Surveyor bears N37W, 1<sup>3</sup> feet from center  
of original tree stump.

Brass Cap Mark:

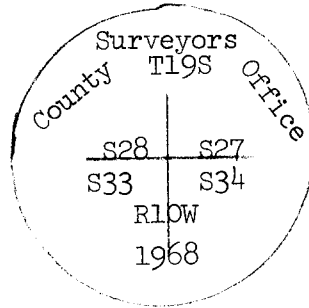

From which:

- 19" orig. D-fir snag 10 feet high bears N39W, Dist. 10<sup>11</sup> ft.
- 12" Orig. D-fir snag 5 ft. high bears N30°E, Dist. 12<sup>20</sup> ft.
- 18" D-fir, bears N86°E, Dist. 27<sup>90</sup> ft.
- 37" D-fir bears S65°E, Distance 47<sup>40</sup> ft.
- 39" orig. D-fir bears S51°W, Distance 12<sup>40</sup> ft.
- 23" D-fir, bears N71W, Distance 13<sup>40</sup> ft.

Feet

3123<sup>05</sup>

3705<sup>51</sup>

4049<sup>07</sup>

4266<sup>83</sup>

4987<sup>61</sup>

5176<sup>60</sup>

FIELD ASSISTANTS

NAMES	CAPACITY
Ernesto R. Alvarado	Survey Party Chief & Instrumentman
Tim Mace	Notes and Rear Chairman
Pat Barnes	Head Chairman
Ron Shelton	Head Chairman
Eric Stolsig	Notes and Rear Chairman
Stu Johnston	Rear Chairman

CERTIFICATE

The retracement and remonumentation represented on this plat is for the purpose of identifying and perpetuating the evidence of monuments and accessories established by the original survey.

This survey and record thereof is prepared as a result of the request of the Supervisor, Siuslaw National Forest and is intended for his exclusive use.

I certify this retracement, remonumentation, and record thereof, was prepared by me or my assistants under my supervisory direction and that same is true and correct to the best of my knowledge.

Gordon H. Long, Cadastral Surveyor, Region 6, Portland, Oregon

