SECTION 35, TOWNSHIP 29 SOUTH, RANGE 5 WEST, WILLAMETTE MERIDIAN, DOUGLAS COUNTY, OREGON

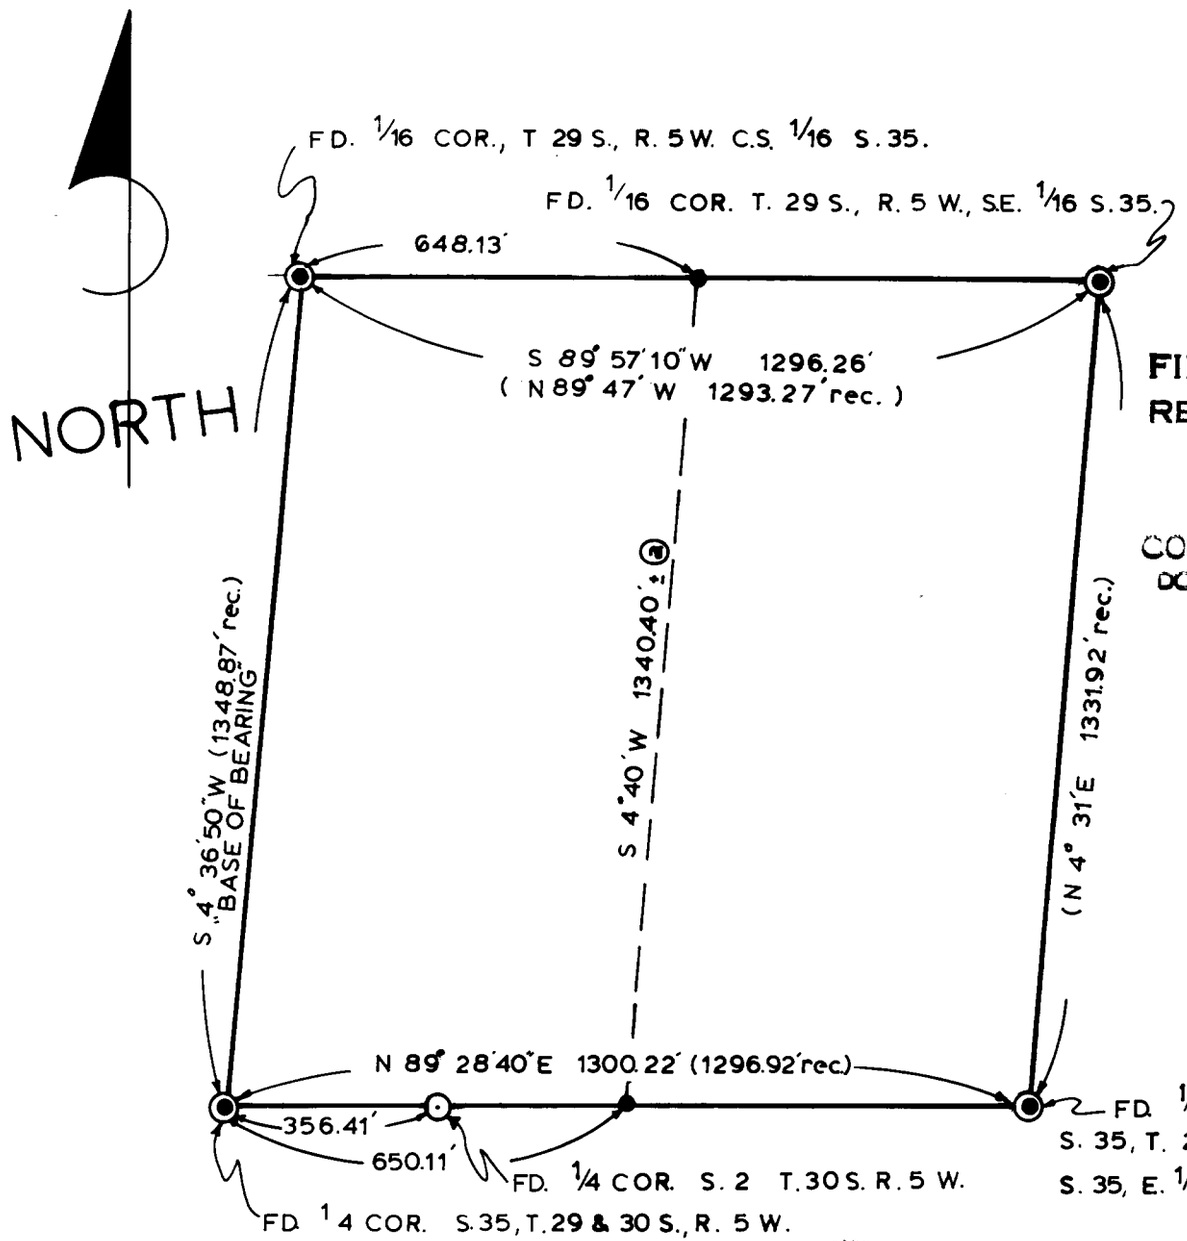

ⓐ dist. estimated

FILED
RECEIVED
MAY 2 1978
COUNTY SURVEYOR
DOUGLAS COUNTY, ORE.

SURVEYED FOR: CURTIS C. JOHNSON
RT. 1 BOX 195
MYRTLE CREEK, OREGON 97457
ph. 863-4321

SURVEYED TO FIND THE WEST HALF OF THE SOUTHWEST QUARTER OF THE SOUTHEAST QUARTER OF SECTION 35, TOWNSHIP 29 SOUTH, RANGE 5 WEST, W.M.

LEGEND:

- ◉ DOUGLAS COUNTY BRASS CAP, ALL SET 1969
- ⊙ B.L.M. BRASS CAP, SET 1969
- ● SET 1 1/2" IRON PIPE

COUNTY SURVEYORS FILE DATA
DO NOT REMOVE FROM OFFICE

JOHN H. MARKHAM JR. O.S.P.E.
MYRTLE CREEK, OREGON

DRAWN BY:
RAYMOND F. BROWN
CANYONVILLE, OREGON

DATE	SCALE
MAR. 1978	1" = 300'

C.S. File No. 58/168-2