

Shaner Engineering, Inc.

PLANNING • SURVEYING • ENGINEERING
P. O. BOX 1430
ROSEBURG, OREGON 97470

FILED
RECEIVED

SEP 12 1978

COUNTY SURVEYOR
DOUGLAS COUNTY, ORE.

NW Corner of DLC No. 43, T22S, R9W, W.M.


I found a 60 to 80 year old 1½ inch iron pipe driven in bed of Bruchard Creek that closely matches call of Oregon State Highway right of way map of 1933; we verified this with transit survey. Pipe also matches original calls for creek in D.L.C. No. 43 notes. Lying over the 1½ inch iron pipe is an 18"x36"x36" Rock, so I marked an "X" directly over the pipe, from which "X" a:

Very old Douglas Fir stump, 34", bears S70°E, 51.0 ft. (record 66.7 ft.)
No scribes found.


Very old badly decayed Douglas Fir stump, 18" + , (record 12"), bears N76°E (record N89°E), 65.4 ft. (record 62.5 ft.). No scribes found.

48" Maple, I scribed "NWC DLC 43 BT" bears N52°E, 50.0 ft.

12" Alder, I bark scribed "T22S R9W NWC DLC 43 BT" bears N36°W, 27.7 ft.

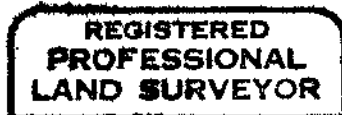

BA Shaner

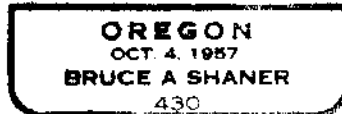

July 9, 1977

Bruce A. Shaner, Surveyor
Mark Heimbürger, Chainman

#82 X