


**CERTIFIED RECORD OF LAND CORNER MONUMENTATION**

**History of original corner establishment:**

Corner set originally in 1894 under General Land Office Contract No. 620 by William M. Bushey, Deputy Surveyor, who set a 14" x 10" x 10" stone, from which:

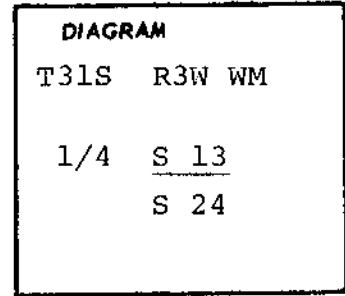

A laurel, 14 inches in diameter, bears S. 73° E 25 links, marked "¼ S B T".

A fir, 30 inches in diameter, bears N 29° E 63 links, marked "¼ S B T". Corner was renewed in 1965 by John M. Powell, Douglas County Surveyors Office, who set a brass cap marked "County Surveyor's Office T31S R3W ¼ S13 S24 1965" from which: a 11 inch Douglas fir bears S 86° E, 9.9 feet, marked "¼S24CSBT"  
**Description of corner evidence found:**

1" iron pipe firmly set, flush with the ground with a 2½" brass cap marked: "County Surveyor's Office T31S R3W ¼ S13 S24 1965" from which:

a 16" laurel, stob, with center of tree burnt out and face visible bears S 73° E, 16.5 feet to face.

A 34" Douglas Fir, snag, with scribe marks "4S" visible on an opened blaze, bears N 29° E, 41.6 feet.

A 11" Douglas Fir, high cut stump, with scribe marks "¼ S24 CS BT" visible on an open blaze bears S 86° E, 9.9 feet.

**Description of monument and accessories established to perpetuate the original location of this corner**

**New Bearing Trees:**

A 6" Douglas Fir, bears N 59° E, 29.3 feet, marked "¼ S 13 BT" on a double blaze and nailed a brass washer stamped "LS 536" into lower blaze.

a 14" Douglas Fir, bears S 89° W, 114.0 feet, marked "¼ S 24 BT" on a double blaze and nailed a brass washer stamped "LS 536" into lower blaze.

Compass declination 20° East.

REGISTERED  
PROFESSIONAL  
LAND SURVEYOR

*Alvin S. Baughman*

OREGON  
COUNTY CLERK  
536

Office of.....Surveyor..... County of.....Douglas.....  
 State of.....Oregon....., I hereby certify that the within instrument was filed in this office  
 for record on the 26 day of September, 1979, at 4 o'clock P.m., (signed)  
 Francis L. Ingram by *Virginia Ferguson*  
 (COUNTY OFFICIAL) (DEPUTY)

RECORDED *jk*

SEP 26 1979

SURVEYOR  
DOUGLAS COUNTY, ORE

C. S. File No. 58/176-10