


CERTIFIED RECORD OF LAND CORNER MONUMENTATION

History of original corner establishment: Corner was originally established by Dennis Hathorn under contract No. 73 in 1857. Hathorn set a wood post and marked: 30" Pine, bears S8°W, 37 lks.; 18" Oak, bears N70°W, 56 lks.; 18" Oak, bears N8°E, 72 lks.; 12" Oak, bears S89°E, 180 lks. In 1904, Fred Mensch, Deputy Surveyor, re-established corner in original position and set a 18"x12"x6" Basalt Stone, destroyed Hathorn's bearing trees and marked new bearing trees: 24" B. Oak, bears N2°E, 83 lks.; 10" R. Fir bears S12°E, 20 lks.; 8" R. Fir bears S39°W, 51 lks.; 24" B. Oak bears N73°W, 57 lks. In a 1917 resurvey, Elmer Strickler, Deputy Surveyor, set a 3" iron post with brass cap marked: T29S R2W S36 S31 S156 T30S 1917. John Powell renewed corner in 1968 and marked: 16" D. Fir N44°W, 26.8 ft.; 15" D. Fir N73°E, 17.5 ft., and remarked a 16" D. Fir, bears S9°E, 13.0 ft.; 10" D. Fir, bears S41°W, 33.0 ft.

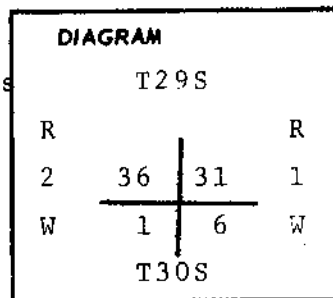

Description of corner evidence found:


1" iron pipe, 10" above the ground with a 2-1/2" Brass Cap marked: "T29S R2W R1W S36 S31 S6 S1 T30S 1917" from which:

- a 22" Oak bears N70°W, 37.0 ft.
- an 18" Oak Stob bears N8°E, 47.5 ft.
- an 18" Oak Stump bears S89°E, 118.8 ft.
- an 18" D.Fir bears N44°W, 26.8 ft.
- a 16" D.Fir bears N73°E, 17.5 ft.
- an 18" D.Fir bears S9°E, 13.0 ft.
- a 12" D.Fir bears S41°W, 33.0 ft.

Description of monument and accessories established to perpetuate the original location of this corner

Marked New Bearing Tree:

10" D. Fir bears S25°E, 38.4 feet, I marked "T30S R1W S6 BT" on a double blaze and nailed a brass washer stamped "LS 536" into lower blaze.

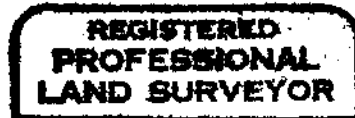

Glenn S. Baughman



Office of SURVEYOR County of DOUGLAS
 State of OREGON, I hereby certify that the within instrument was filed in this office
 for record on the 18 day of JULY, 1979, at 2 o'clock 30 m., (signed)
James A. Ingram by *Glenn S. Baughman*
 (COUNTY OFFICIAL) (DEPUTY)

#132 T29-1 ✓
 #112 T29-2 ✓
 #196 T30-1 ✓ #228 T30-2 ✓
 Form R6-7100-57 (9/66)