SURVEY FOR DEED DESCRIPTION
FOR ORAL JONES

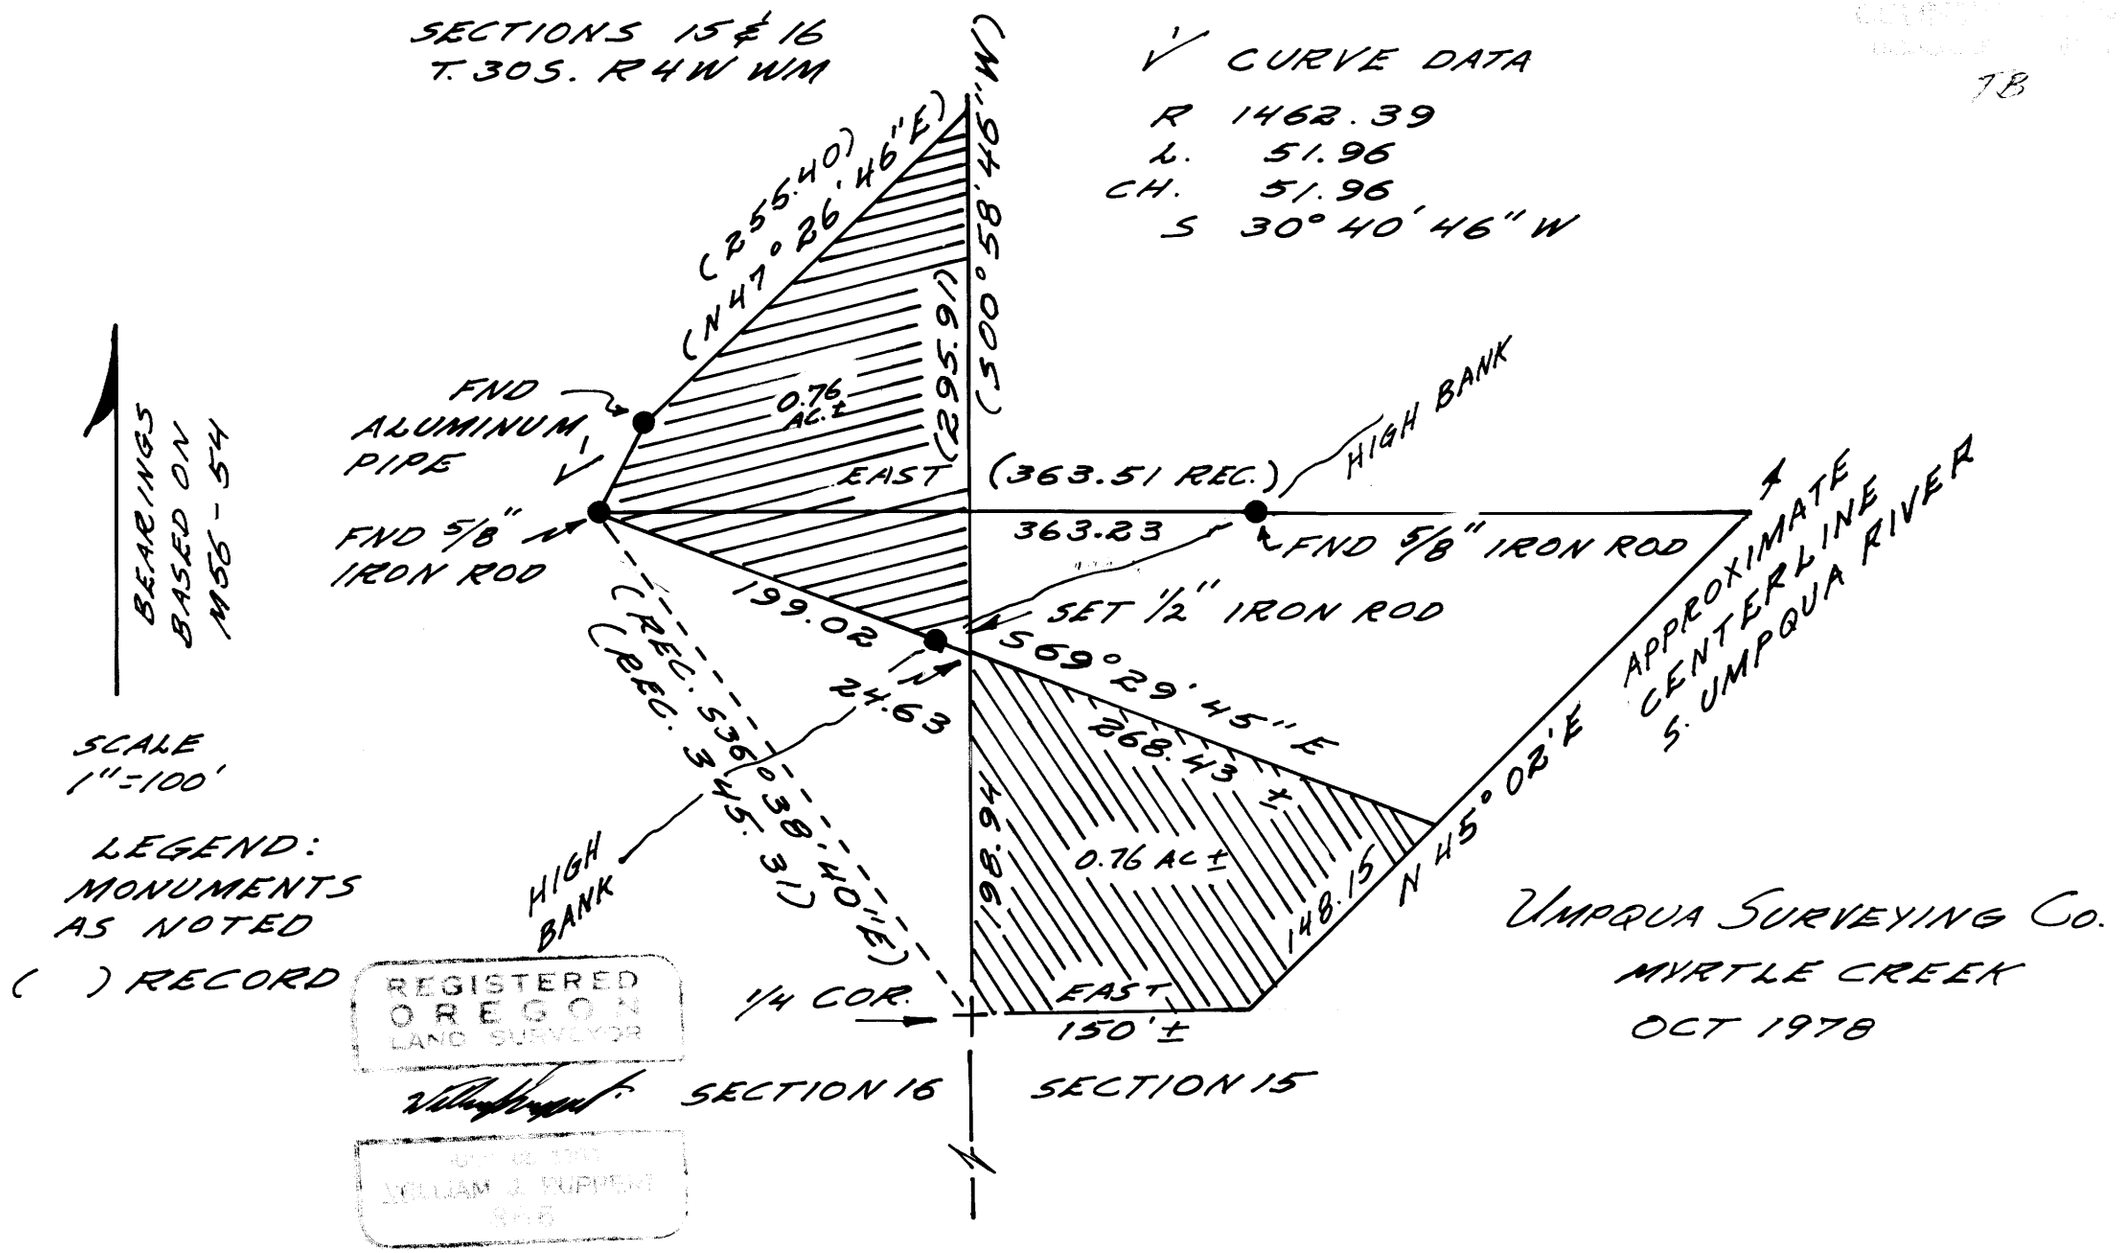

58/177-3