SURVEY FOR HAROLD COX
in
Lots 5, 6, and 7, Deerfield subdivision, Sec 5, T30S, R5W, W.M., Douglas Co., Oregon

COUNTY SURVEYORS FILE DATA
DO NOT REMOVE FROM OFFICE

FILED
RECEIVED
JAN 15 1979
COUNTY SURVEYOR
DOUGLAS COUNTY, ORE.

JANUARY 1979

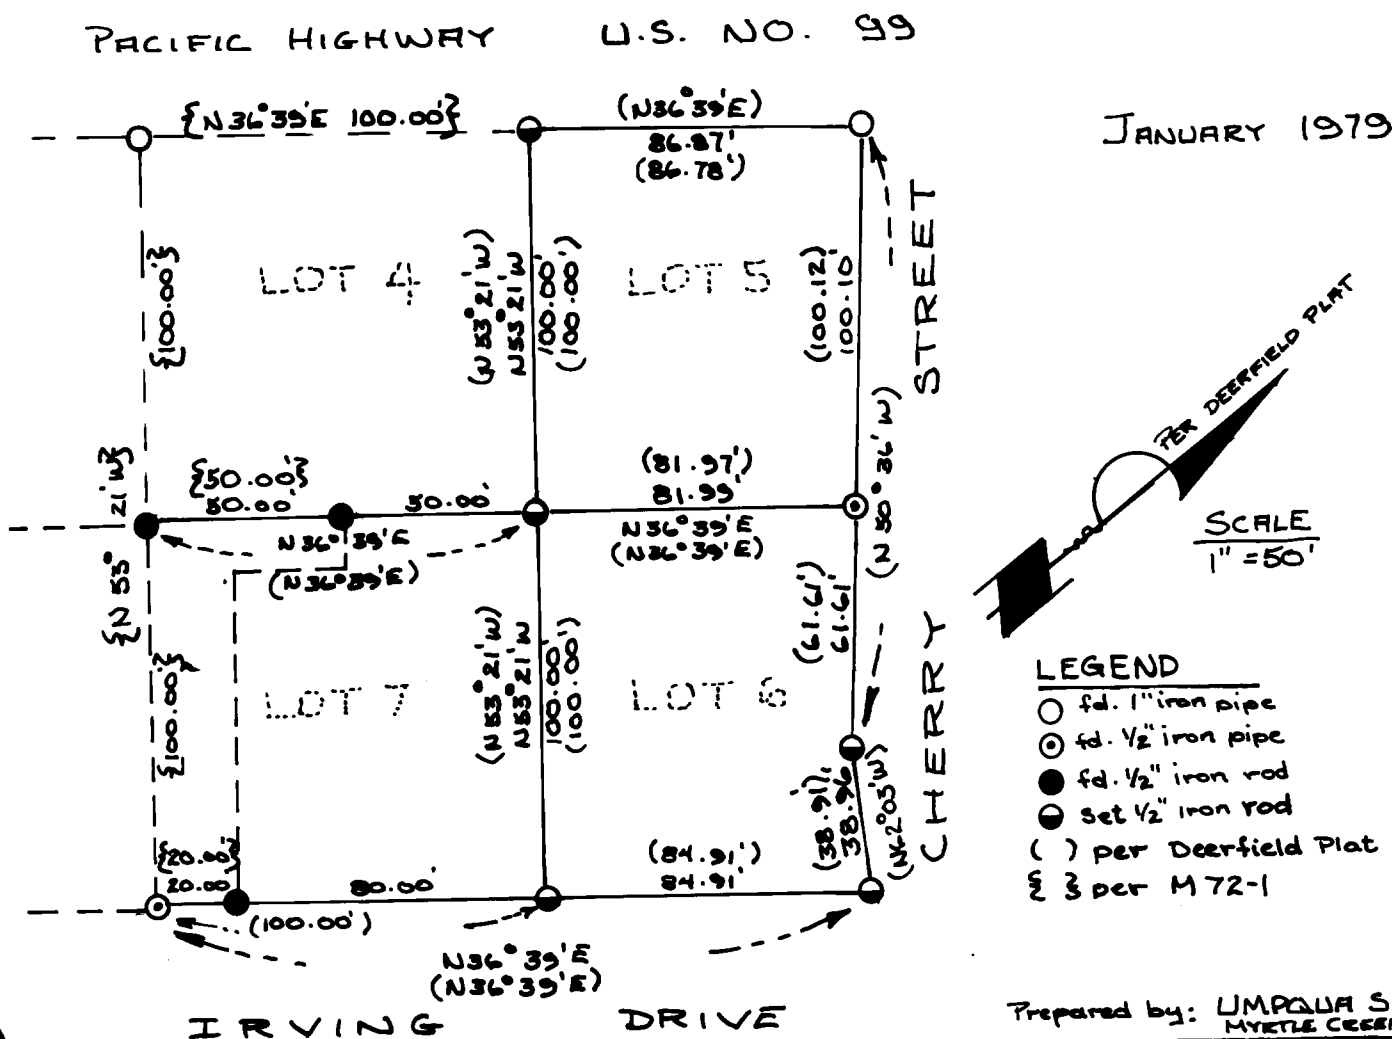

REGISTERED
OREGON
LAND SURVEYOR

JULY 12, 1968
WILLIAM J. RUPPERT
866

Prepared by: UMPQUA SURVEYING Co
MYRTLE CREEK, OREGON

C. S. File No. 58/177-4