SURVEY OF DEED DESCRIPTION

in Sec. 4, T. 33S., R. 6W., W.M.

Deed Vol. 278 Page 787
Douglas County Deed Records

For José & Judy Gallego

FILED ✓
RECEIVED ✓

MAR 2 1979

COUNTY SURVEYOR
DOUGLAS COUNTY, ORE.
TB

COUNTY SURVEYORS FILE DATA
DO NOT REMOVE FROM OFFICE

LEGEND

- ● SET 1/2" IRON ROD
- ○ FOUND 5/8" IRON ROD PER M 75-16
- ⊙ FOUND 5/8" IRON ROD PER M69-57
- ○ FOUND 1" IRON ROD PER M 49-21
- ( ) RECORD COURSE PER DEED
- [ ] RECORD COURSE PER PREVIOUS SURVEY

NOTE: Land may be subject to more rigorous location of MARSHALL AVE.

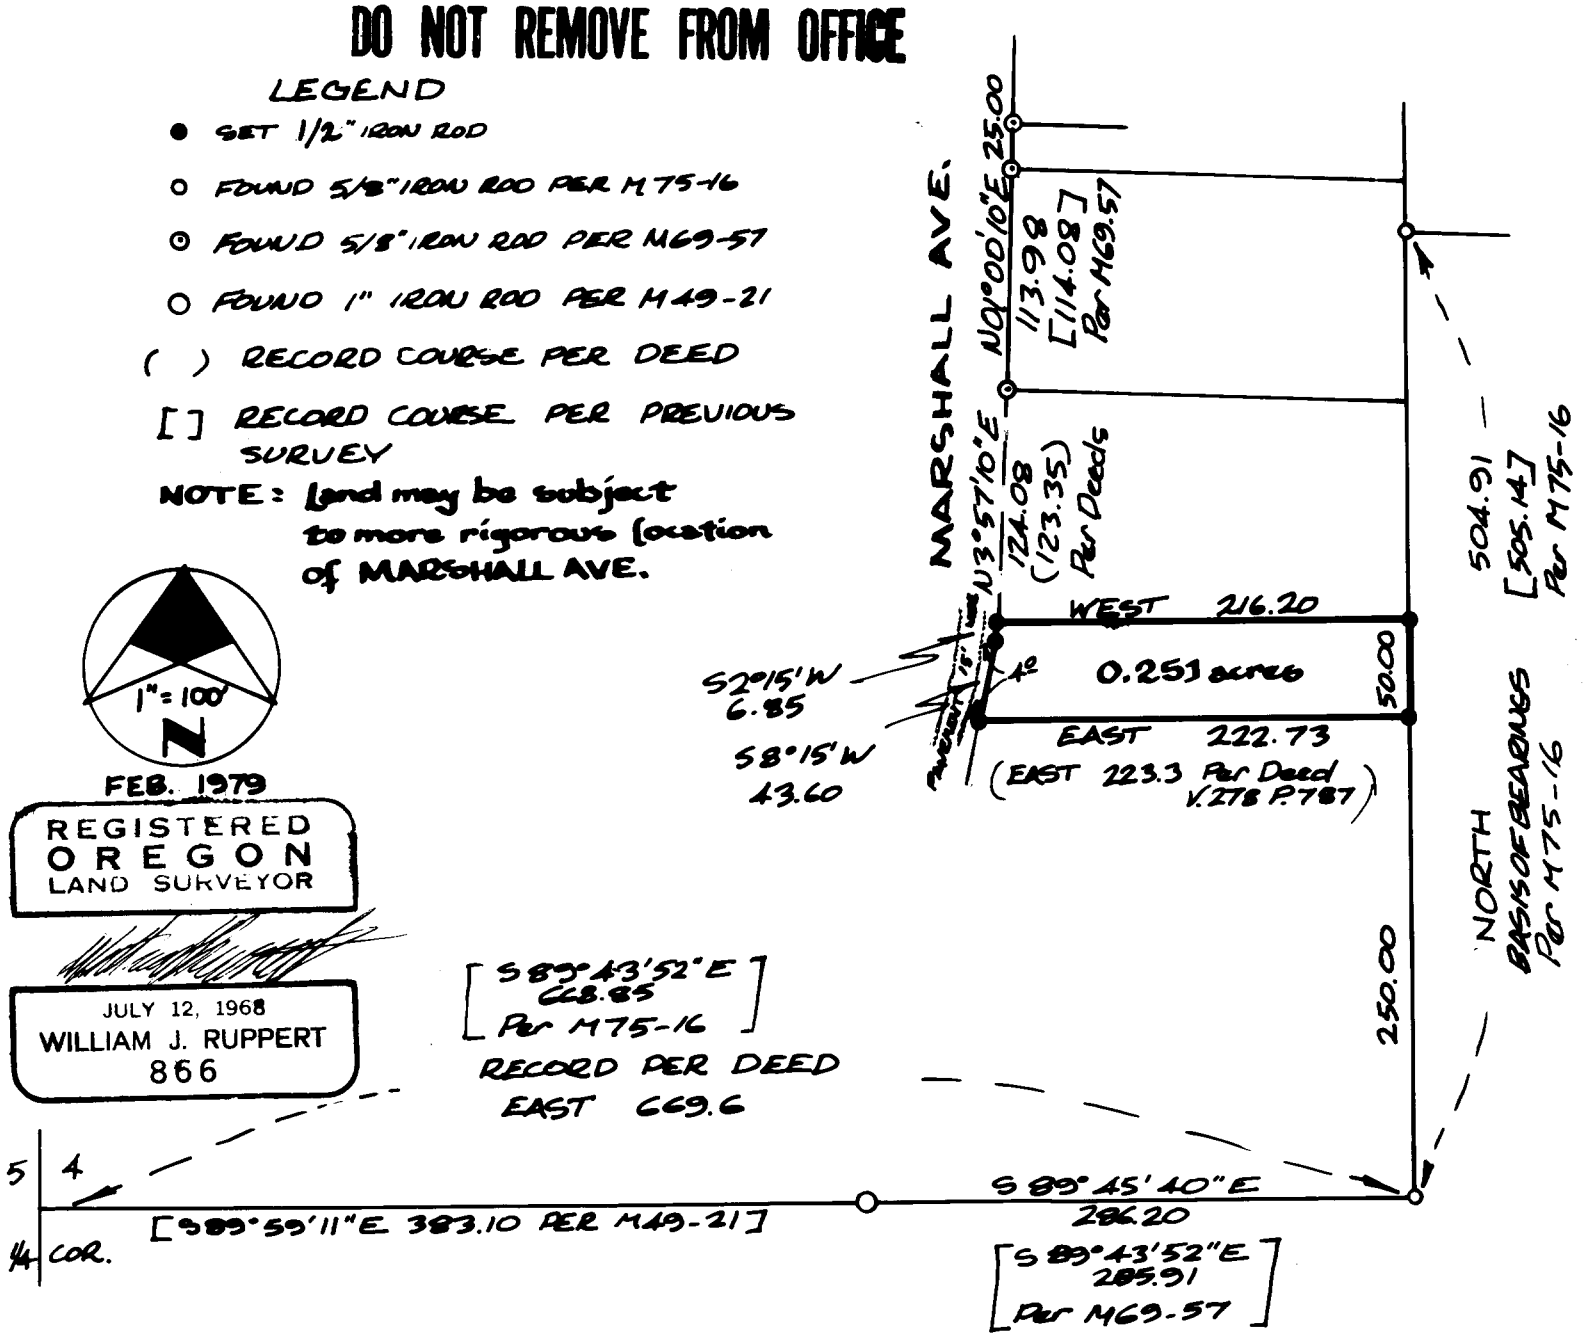

FEB. 1979

REGISTERED
OREGON
LAND SURVEYOR

JULY 12, 1968
WILLIAM J. RUPPERT
866

By UMPQUA SURVEYING CO.
626 NE. DIVISION MYRTLE CREEK, ORE.
863-5201

U. S. File No. 58/177-6