58/178

SURVEY FOR DESCRIPTION

IN SECTION 20, T.25S. R.5W. W.M.

FOR: FREDERIC HARRINGTON

BY: BAUGHMAN TECHNICAL SERVICES INC.

JANUARY 1979 — SCALE: 1"=200'

COUNTY SURVEYOR
DOUGLAS COUNTY, ORE.
FILED
RECEIVED

REGISTERED
PROFESSIONAL
LAND SURVEYOR

Glenn A. Baughman

GLENN A. BAUGHMAN
536

COUNTY SURVEYORS FILE DATA
DO NOT REMOVE FROM OFFICE

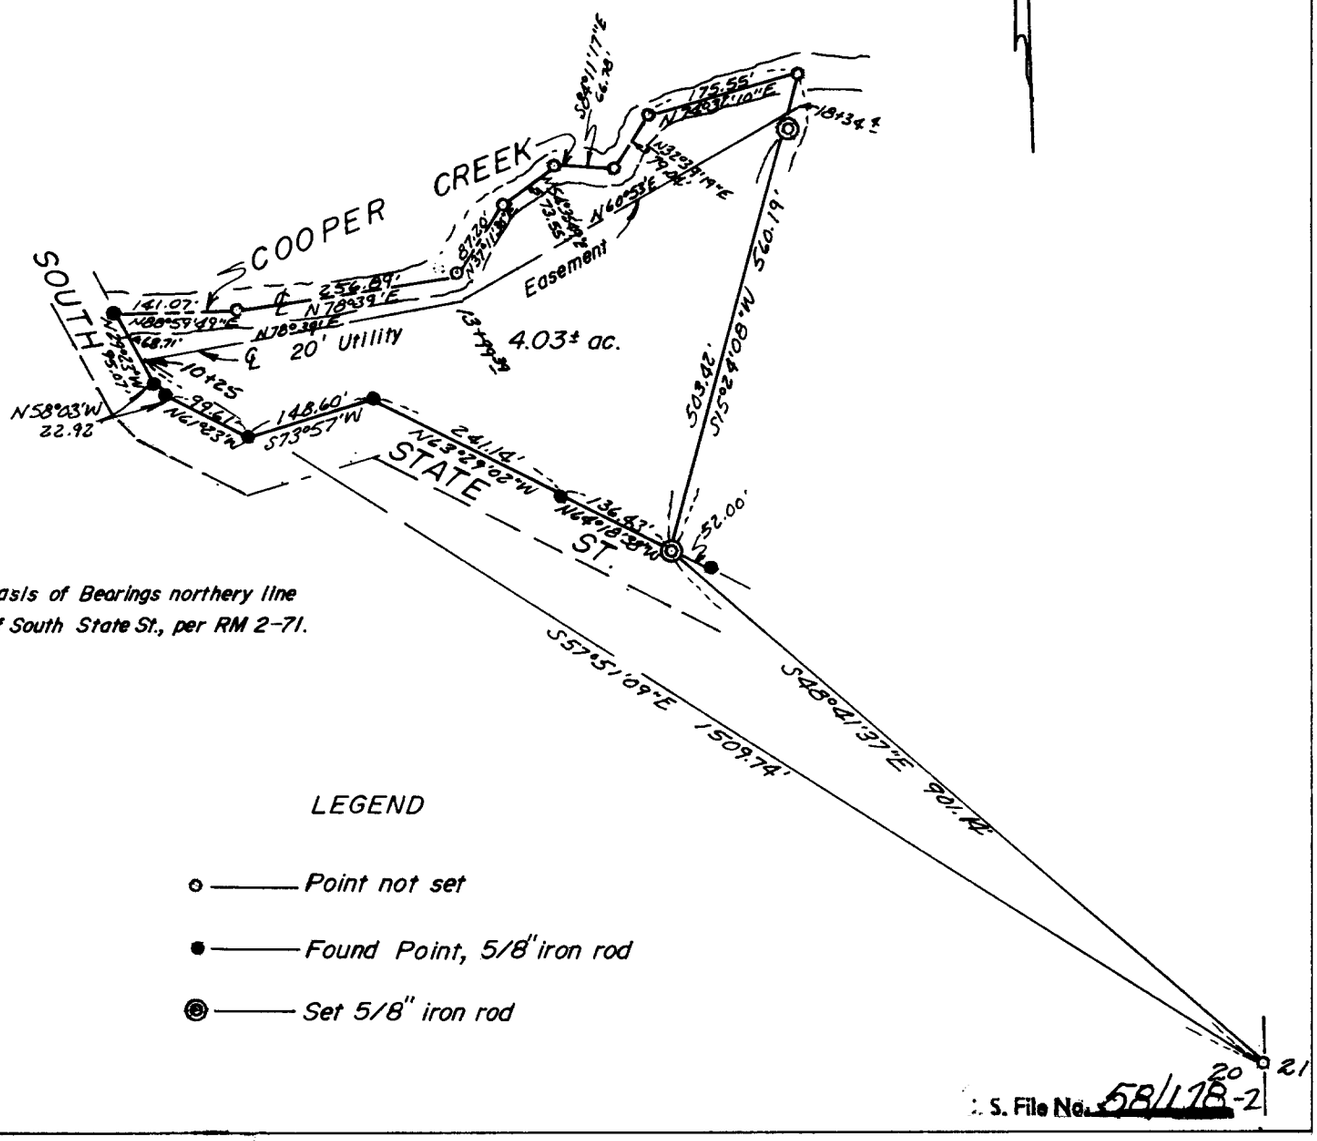

Basis of Bearings northery line of South State St., per RM 2-71.

LEGEND

- o —— Point not set
- ● —— Found Point, 5/8" iron rod
- ◎ —— Set 5/8" iron rod

S. File No. 58/178-2

FM 4-108