C.S. 58/178-6

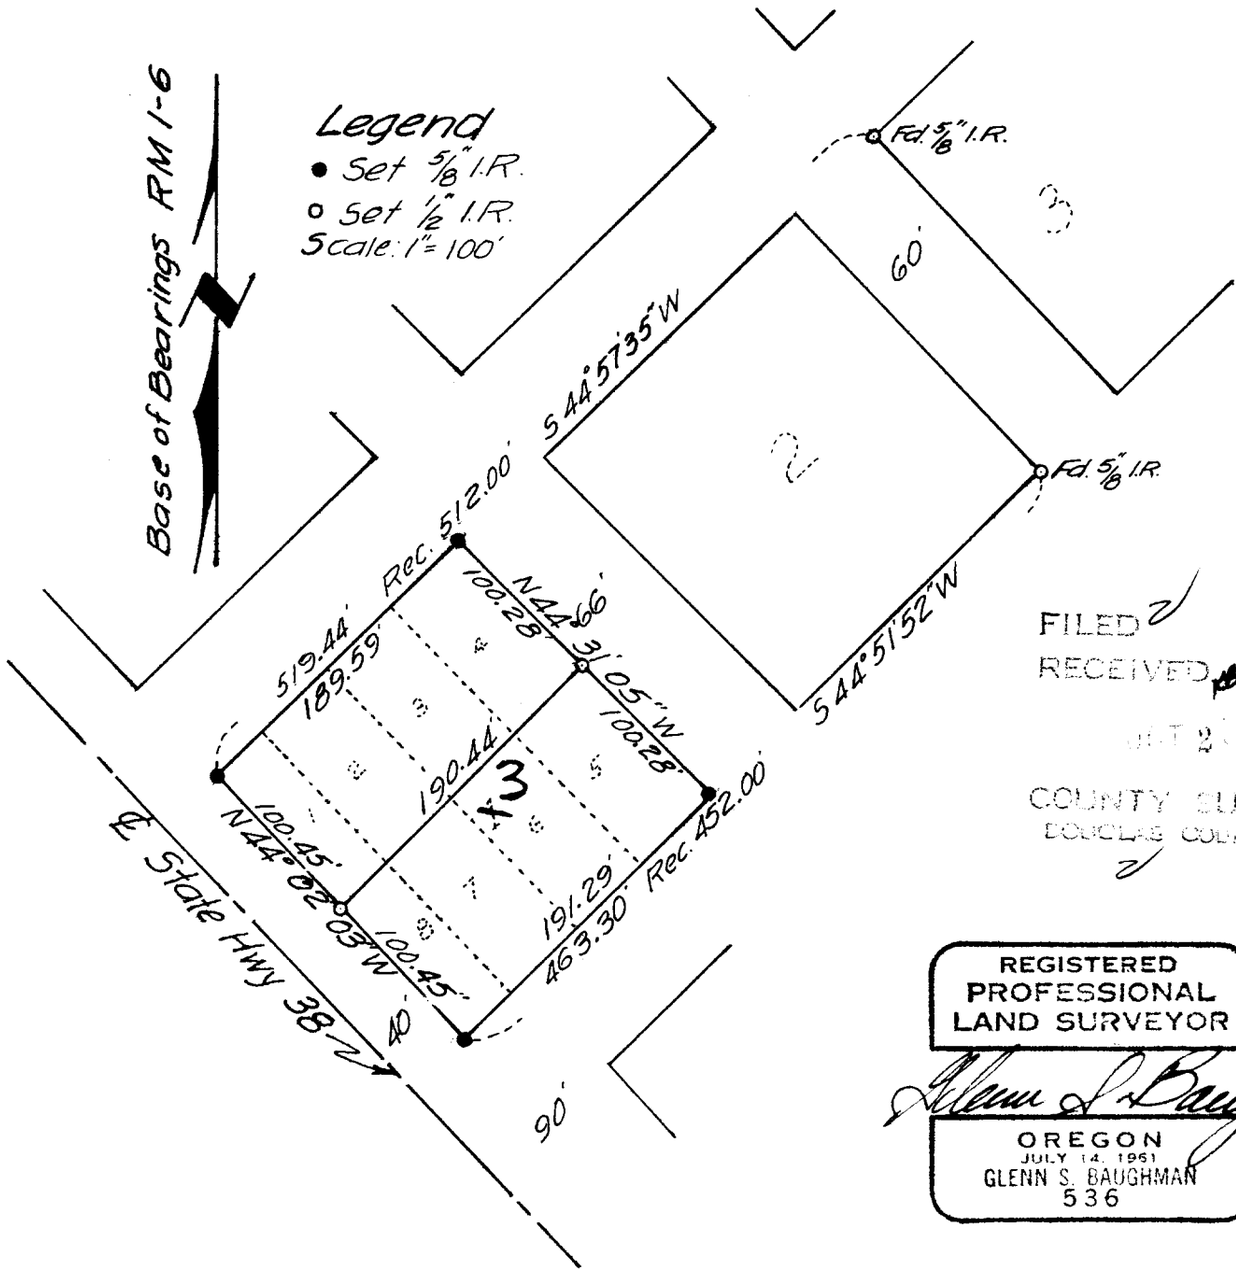

FILED
RECEIVED
OCT 2 1979
COUNTY SURVEYOR
DOUGLAS COUNTY, ORE.

REGISTERED
PROFESSIONAL
LAND SURVEYOR

OREGON
JULY 14, 1961
GLENN S. BAUGHMAN
536

SURVEY FOR PROPERTY CORNERS
FOR CASCADE UTILITIES
BY BAUGHMAN TECHNICAL SERVICES, INC.
BLOCK ~~1~~ 3 PLAT OF ELKTON
SECTION 20, T. 22 S., R. 7 W.,W.M.
AUSUST 1979

FM 4-114

C.S. 58/178-6
C.S. File No.