SURVCY FOR ROAD EASYMENT

FILED
RECEIVED
OCT 4 1978
COUNTY SURVEYOR
DOUGLAS COUNTY, ORE.

SECT, 21, T. 22 S., R. 8 W. W.M.

D.L.C. # 44

Merel Godding Elkton, Oreg. 97436

Beginning at a point in old county Road from which point the N.W. corner of D.L.C. #44 T.22S., R.8W., W.M. Bears N.30°00'E. 27.78 ft. and S.65°00'W. 26.36 ft. and North 65.00 ft. Thence N 30°00'E 27.78 ft. To a Rail Road spike, Thence N. 44°05' E. 90.94 ft. To a Rail Road spike on the South line of Land owned by . . . . . and described in Vol. . . . . Page . . . . . Deed Records Douglas county, Oregon.

[redacted] DATA

REGISTERED
OREGON
LAND SURVEYOR
Wilford N. Haines
MAY 7, 1948
WILFORD N. HAINES
239

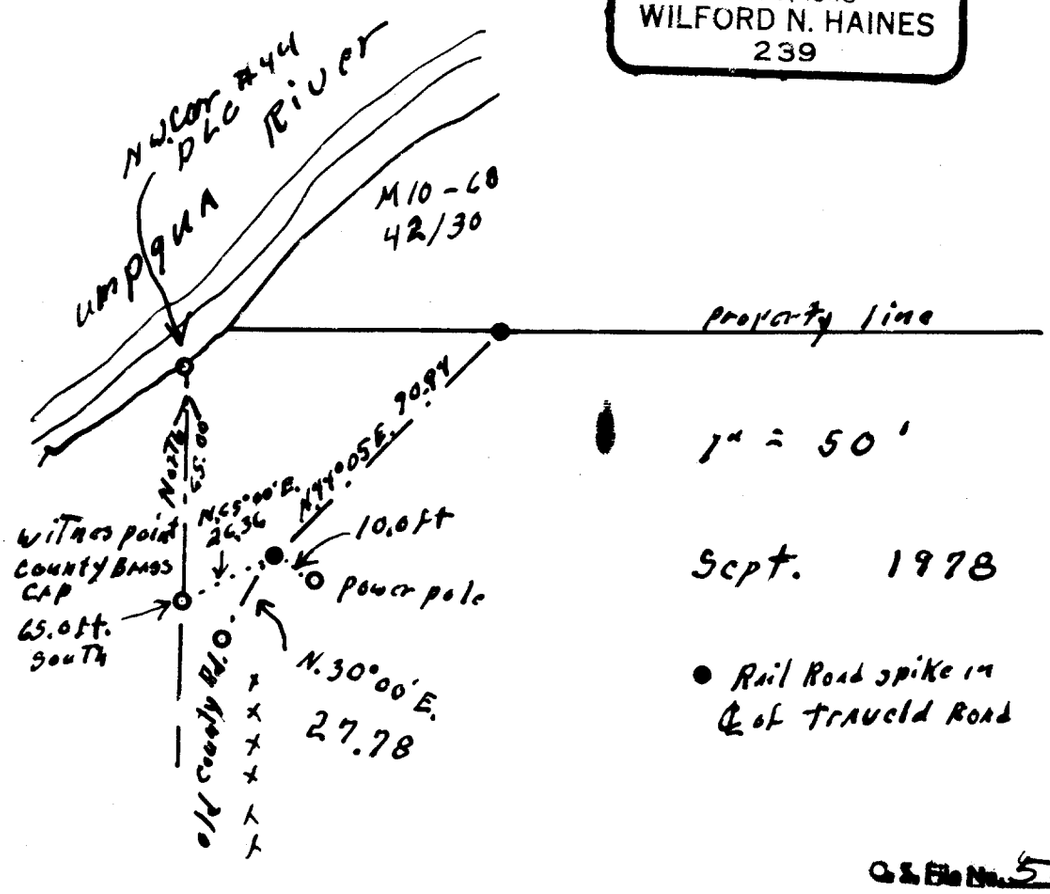


C.S. File No. 58/181-1