# LOT LINE ADJUSTMENT

## FOR

## VERN H. LIESINGER SR.

IN LOT 38, EDENBOWER ORCHARD TRACTS
SECTION 12, T27S R6W, W.M. DOUGLAS COUNTY, OREGON
DECEMBER, 1979

(SEE M77-6)

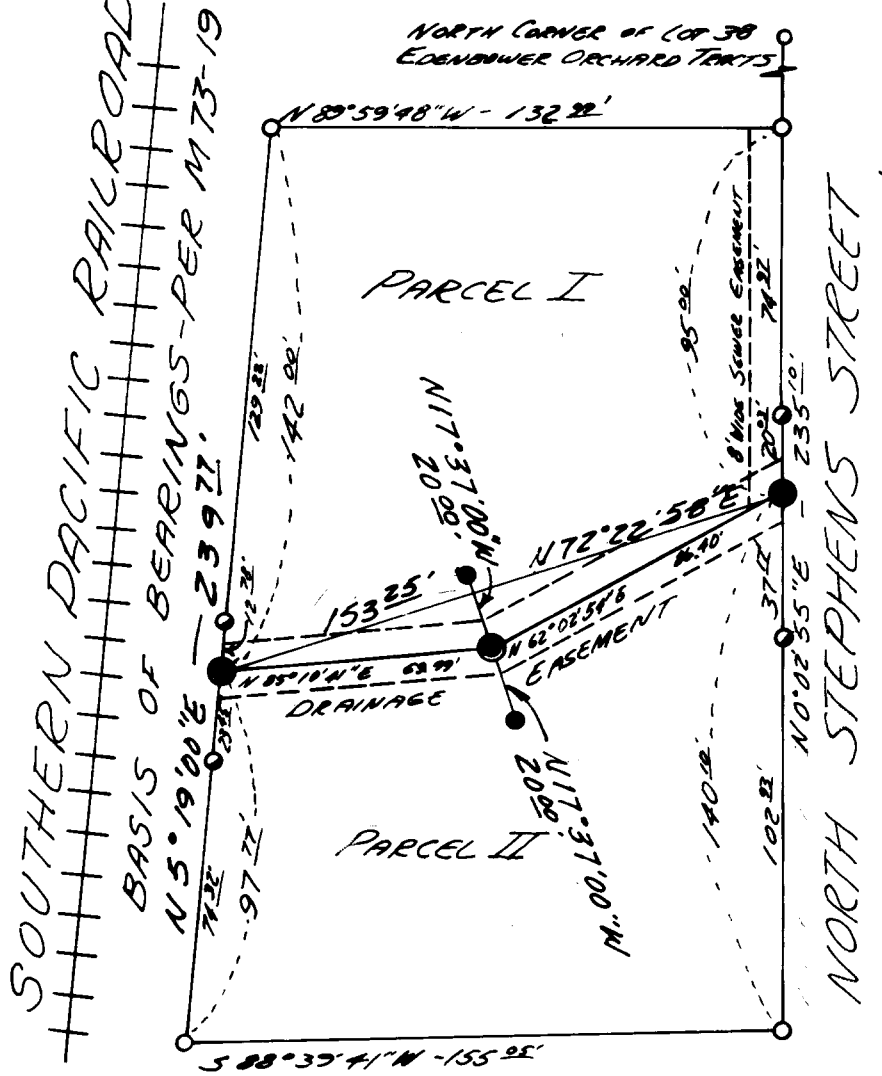



ENGINEER: ALPHA & OMEGA ENG. INC.
1622 N.E. VINE
ROSEBURG, ORE., 97470
672-7151

SURVEYOR: RUSSELL T. PINARD
1622 N.E. VINE STREET
"FRONTIER VILLAGE"
ROSEBURG, OREGON
97470


FILED
RECEIVED JHH
DEC 17 1979
COUNTY SURVEYOR
DOUGLAS COUNTY, ORE.

REGISTERED
PROFESSIONAL
LAND SURVEYOR
Russell T. Pinard
OREGON
JULY 16, 1971
RUSSELL T. PINARD
958

SCALE: 1"=50'

LEGEND

- ● FOUND 5/8" REBAR
- ○ FOUND 3/4" REBAR
- ● SET 5/8" x 30" REBAR
- ( ) RECORD INFORMATION
- ● PROPERTY CORNER (NOT SET)


COUNTY SURVEYORS FILE DATA
DO NOT REMOVE FROM OFFICE


U. S. File No. CS 58/191-2