Residence on & Boundaries of
Lot 5 - Rust Subdivision
T. 27 S., R. 5 W., W.M.
Douglas County, Oregon

FILED
RECEIVED

FEB 21 1979

COUNTY SURVEYOR
DOUGLAS COUNTY, ORE.

COUNTY SURVEYORS FILE DATA
DO NOT REMOVE FROM OFFICE

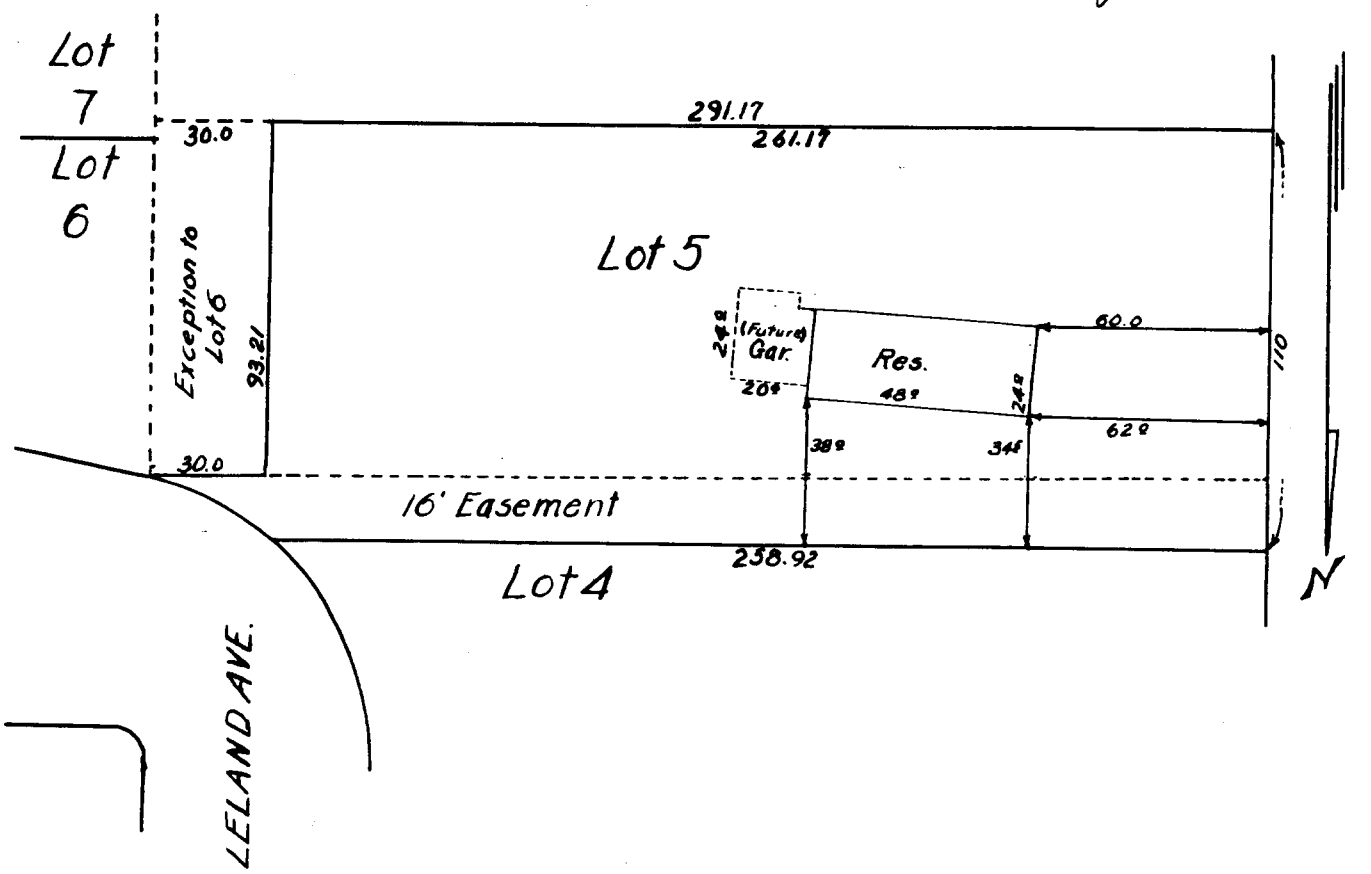

Date: April 13, 1954
Scale 1" = 50'

I hereby certify that I have surveyed the above described property and that the improvements shown hereon are within the property lines

Wally M Hector.

Wally M Hector

C.S. File No. 58/192-1