FILED
RECEIVED
MAR 22 1979
COUNTY SURVEYOR
DOUGLAS COUNTY, ORE.

COUNTY SURVEYORS FILE BOOK
DO NOT REMOVE FROM OFFICE

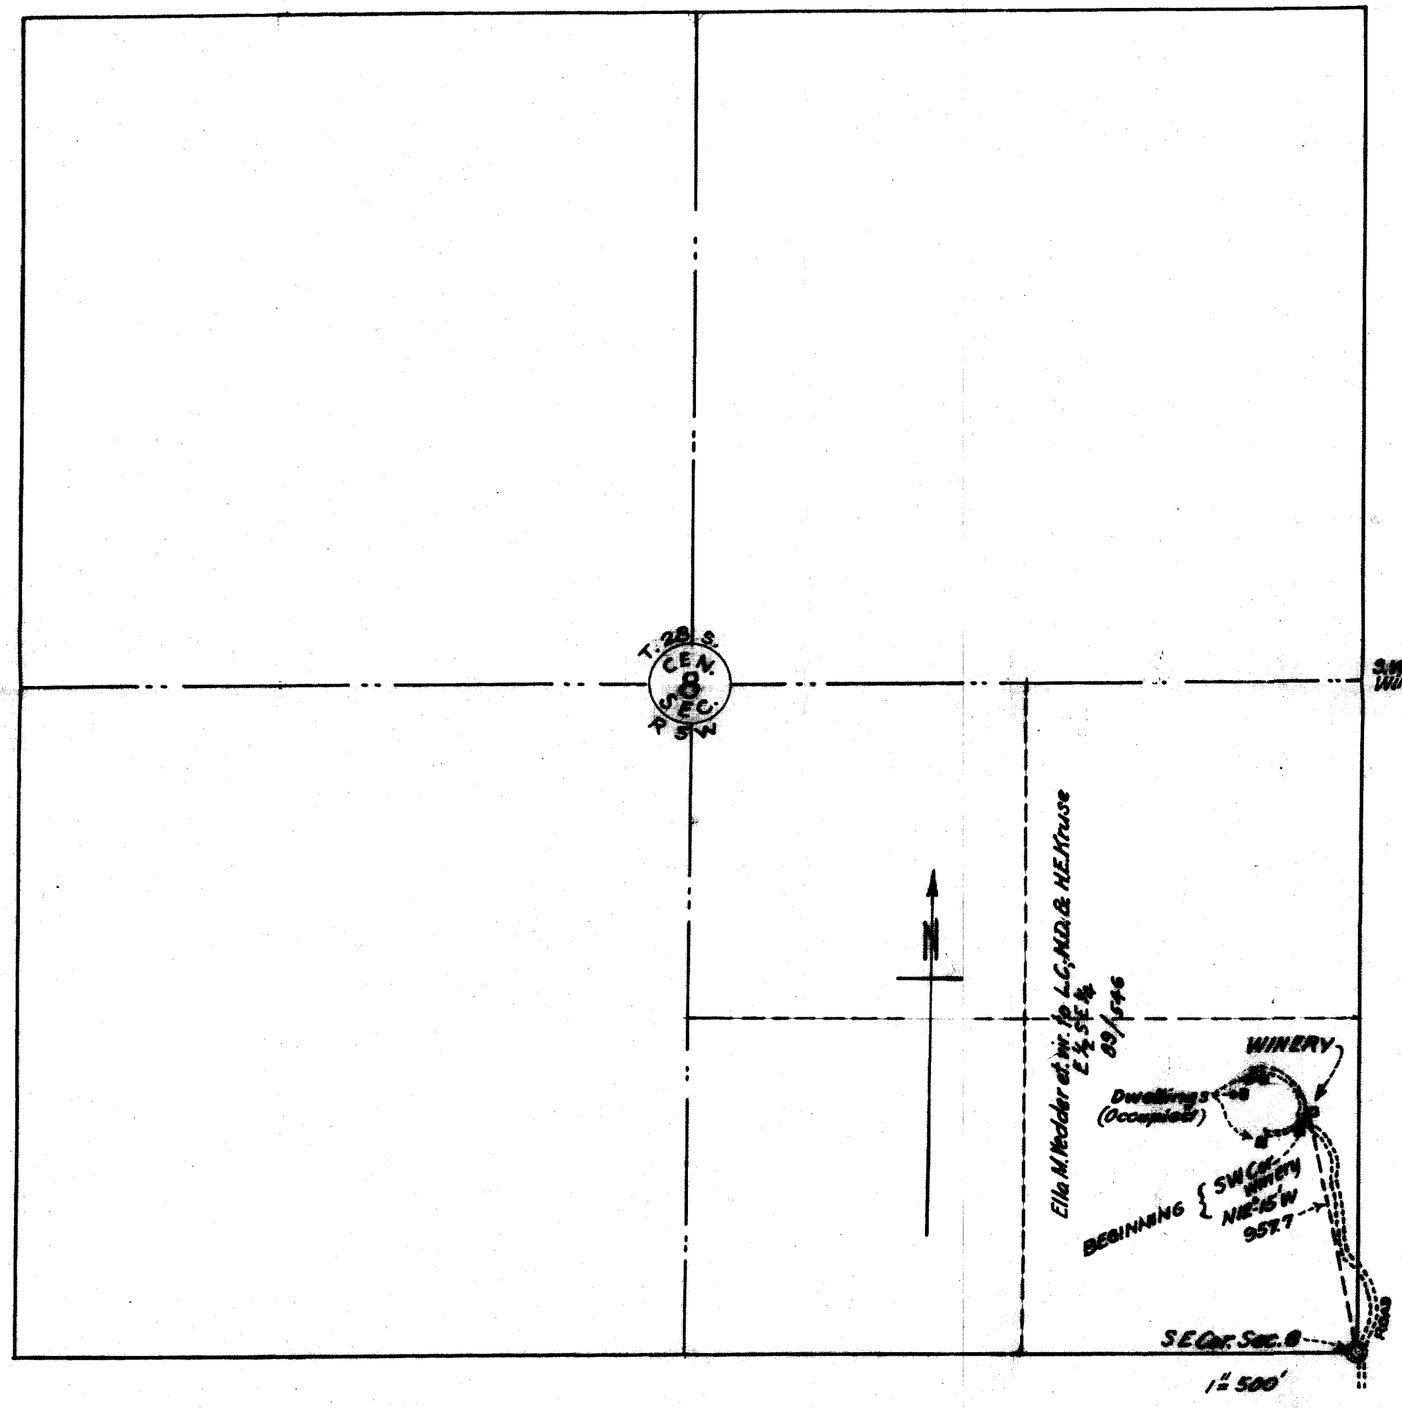

Boundary Description Winery Premises

Commencing at a point which is N 12°15'W 957.7 ft. from the South East corner of Sec. 8, T. 28 S., R. 5 W. W.M. thence N 4° W. 18. ft. to a point, thence N 86° E. 24. ft. to a point, thence S. 4° E. 18. ft. to a point, thence S. 86° W. 24. ft. to the place of commencement, all in the SE¼ of the SE¼ of Sec. 8, T 28 S., R 5 W, Willamette Meridian, Douglas County, Oregon.

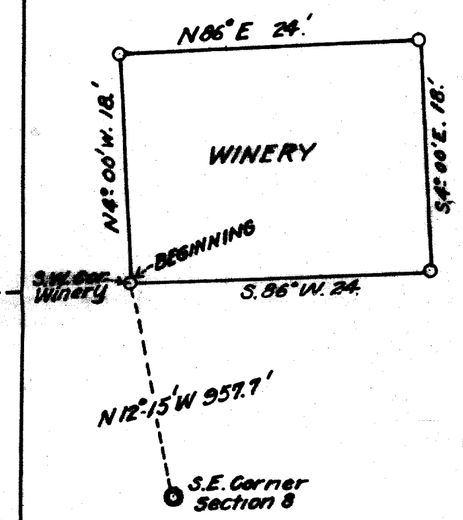

..... District 1940

It is hereby certified that this is an accurate original plat and plan of the Bonded Winery No. ..... premises of Kruse Brothers, Rural Route No. 1, Roseburg, Oregon, in this district.

..... Draftsman

Date of District Supervisor's approval,

..... Proprietor

..... 194

..... District Supervisor

SHEET 1

C. S. File No. C.S. [illegible]-5