FILED
RECEIVED
MAR 22 1979
COUNTY SURVEYOR
DOUGLAS COUNTY, ORE.

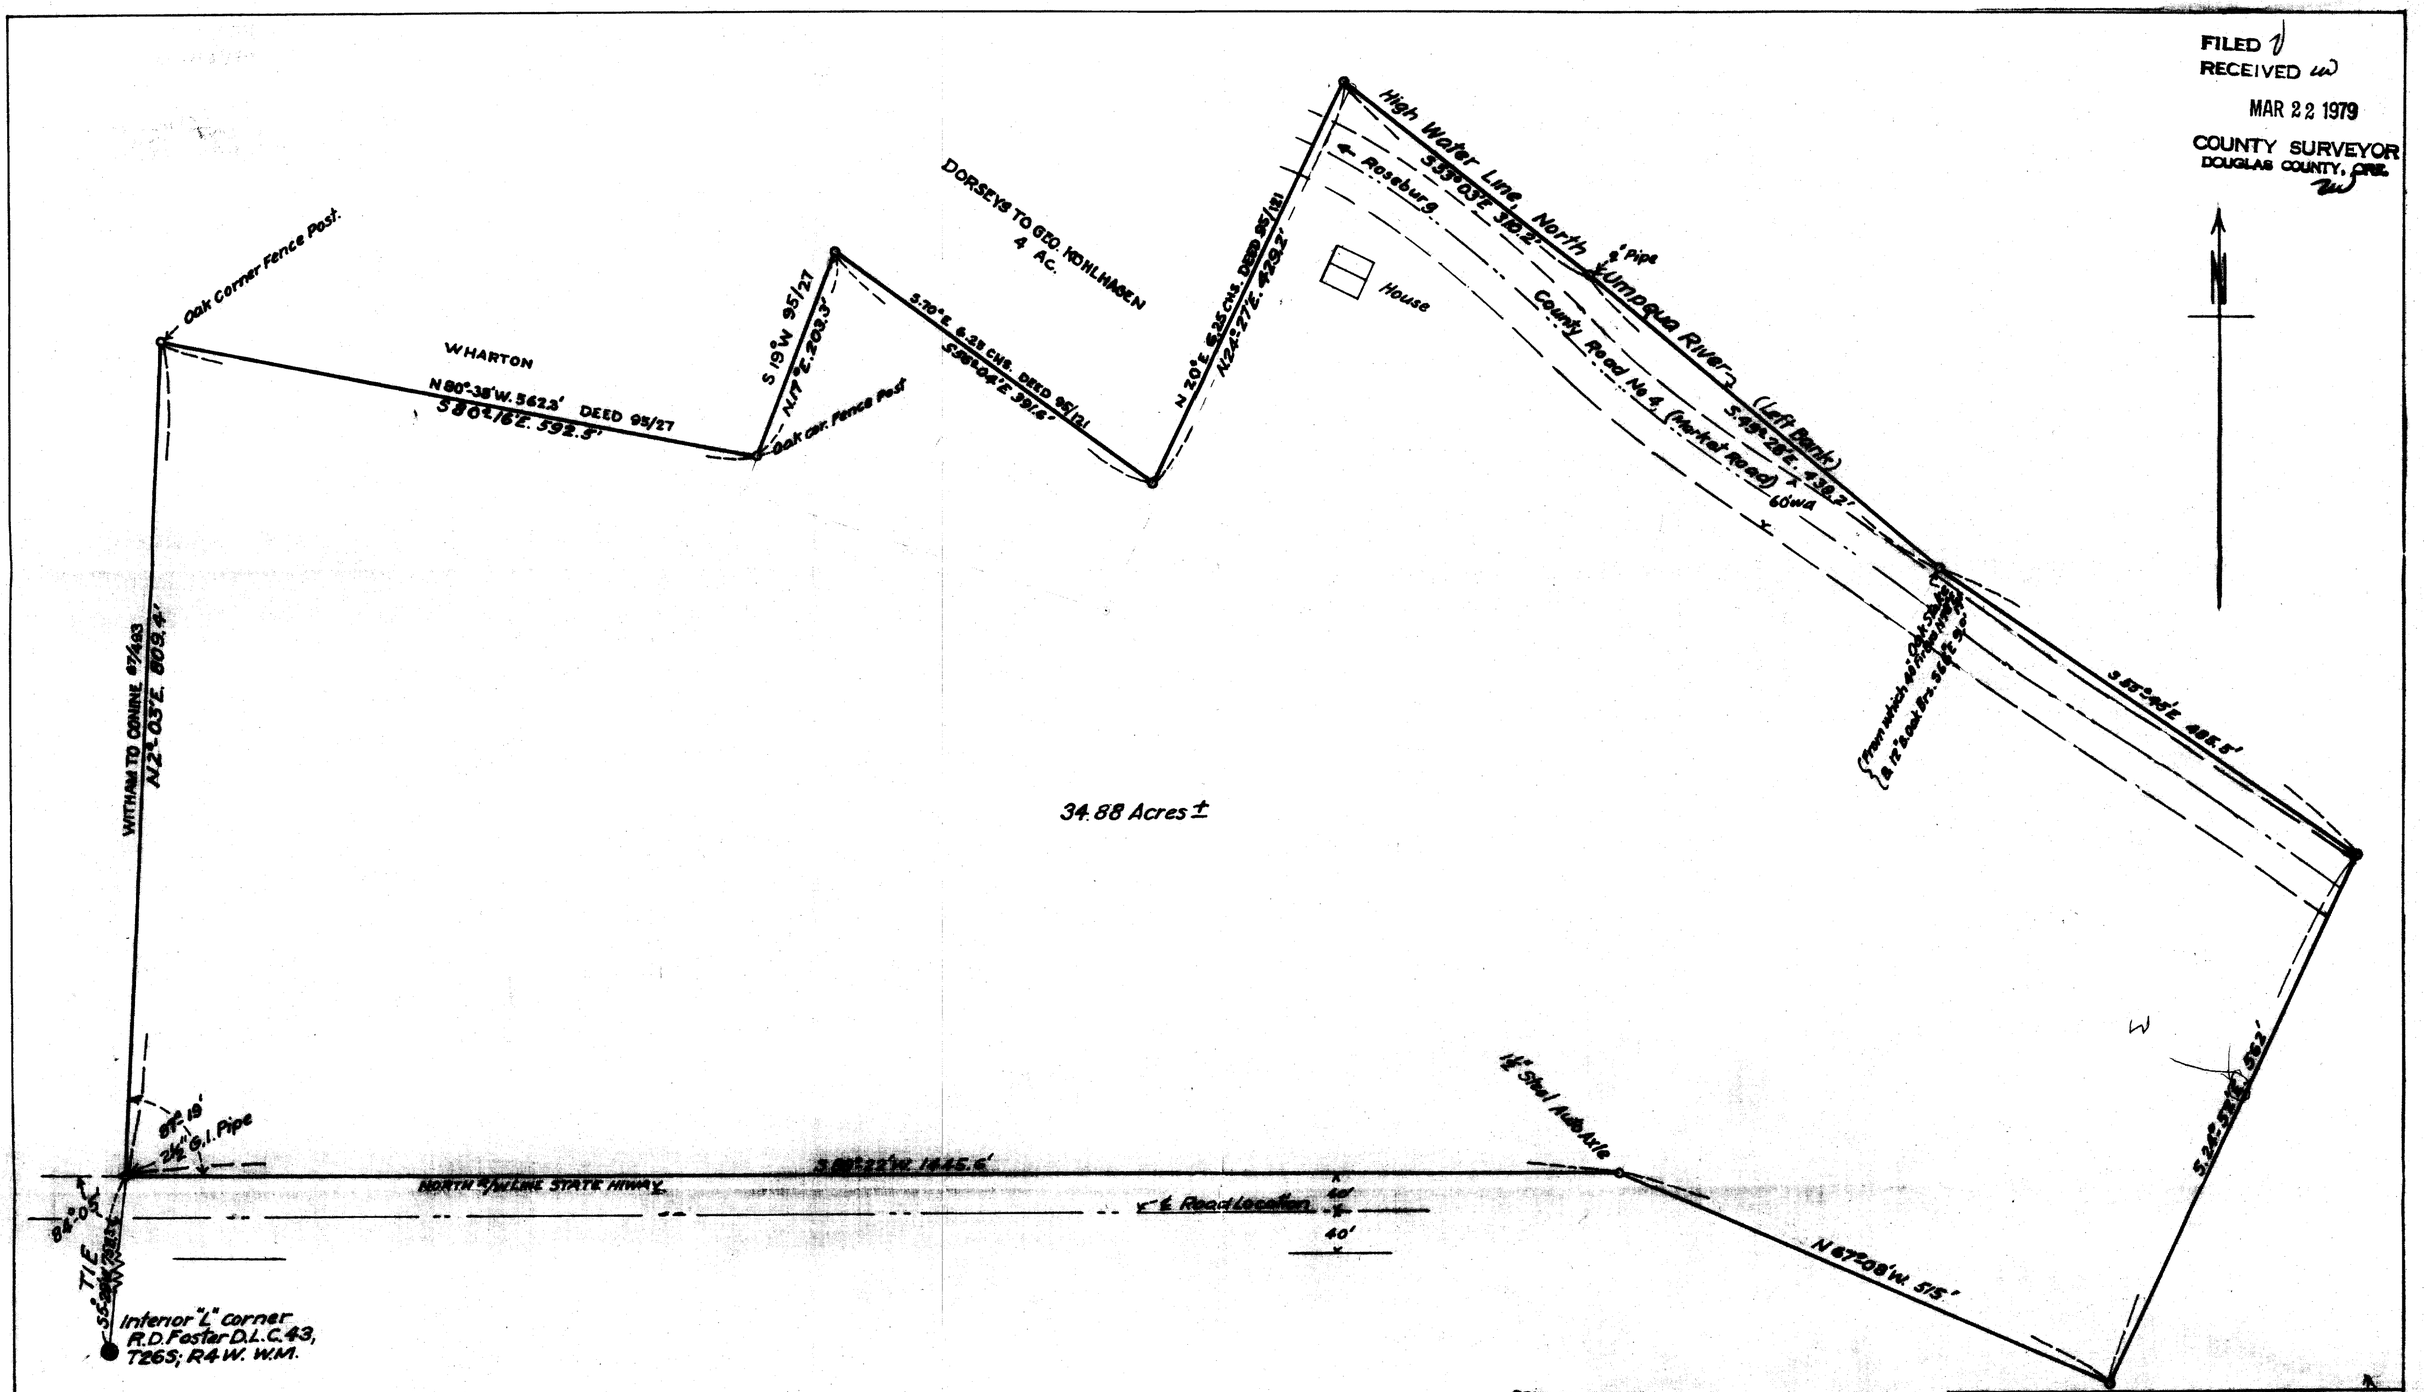

COUNTY SURVEYORS FILE DATA
DO NOT REMOVE FROM OFFICE

COUNTY SURVEYOR'S OFFICE, ROSEBURG, DOUGLAS COUNTY, ORE.

J. I. GARFIELD NORTH UMPQUA RANCH IN
R. D. FOSTER DON. LND. CL. 43, T26S, R4W, W.M.
IN S½ SEC 13, DOUGLAS COUNTY, OREGON.

A. [illegible] CO. SURVEYOR. SCALE 1" = 100 FT.
DATE [illegible] SEPT. 1940. D-25.
C. S. File No. [illegible]

27.08
6.50
3.3
27.08