

NW CORNER
SW 1/4 NE 1/4 SEC. 11

S 89° 28' E
444.55

S 89° 27' E
477.3



N 12° 28' W
222.47

BILGER CREEK ROAD

3.80 ACRES

N 70° 08' W
20.45

N 31° 49' E
202.99

S 6° 15' W
271.56


S 59° 44' W
372.76

N 71° 52' W
143.31

TO MYRTLE CREEK

FILED
RECEIVED
JUN 2 1980

COUNTY SURVEYOR
DOUGLAS COUNTY, ORE.

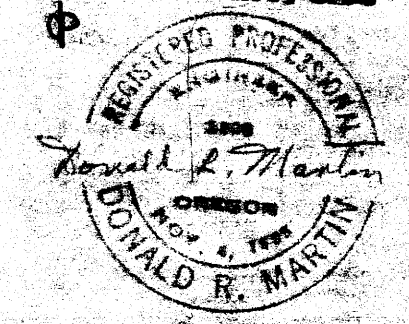

COUNTY SURVEYORS FILE DATA
DO NOT REMOVE FROM OFFICE

COUNTY SURVEYORS FILE DATA
DO NOT REMOVE FROM OFFICE

OCTOBER 1967

FIELD SURVEY & PLAT FOR
TROY A. WALLACE
MYRTLE CREEK, ORE.

PARCEL IN SW 1/4 NE 1/4 SEC. 11 T29S R5W W.M.
DOUGLAS COUNTY, OREGON

SCALE: 1" = 50'

MARTIN ENGINEERING SERVICE ~ MYRTLE CREEK, OREGON

863-3211