SURVEY TO RESET LOT CORNERS

Lot 7 Block 1 Lavona Heights Sec. 22

T. 29S., R. 5W.
W.M.

For Joan Rosenbaum

COUNTY SURVEYORS FILE DATA
DO NOT REMOVE FROM OFFICE

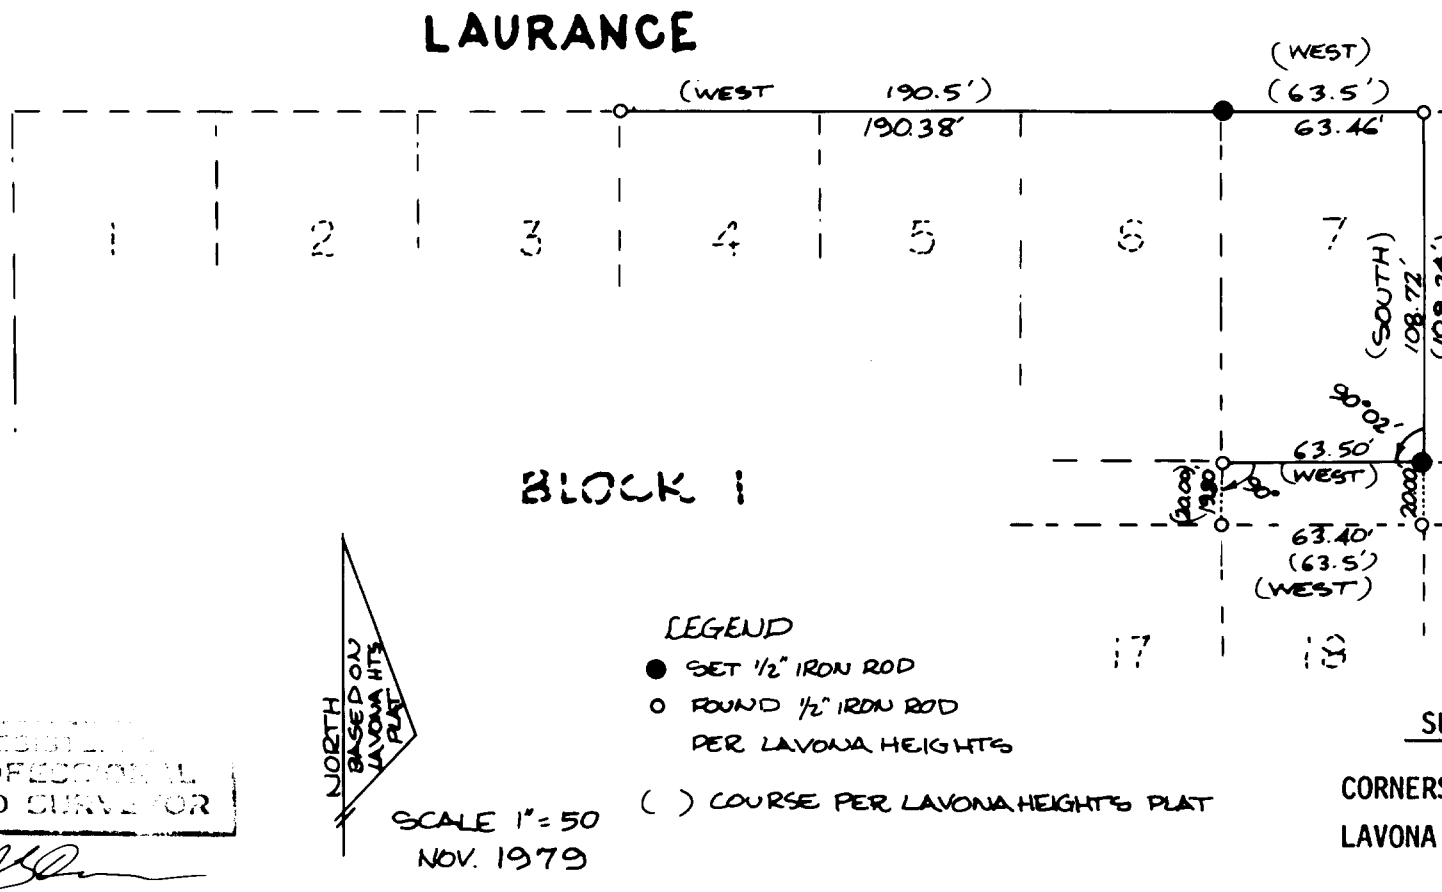

PROFESSIONAL LAND SURVEYOR

OREGON
ROBERT G. DEAN
1808

CORNERS
LAVONA

Umpqua Surveying Co.
626 Division Myrtle Creek 862