SURVEY TO RESET A PROPERTY PIN IN ECHO BEND ESTATES, SECOND ADDITION, N.W. 1/4, SEC. 23, T 26S, R 5W, W.M. DOUGLAS COUNTY, OREGON

FOR: HENRY H. MILLER INC.
BY: ROBERT L. DOLAN
RT. 1 BOX 1820
SUTHERLIN, OREGON 97479
BASE BEARING: ECHO BEND ESTATES
PROCEDURE: PIN RESET FROM FOUND PINS
DATE: DEC. 1979

COUNTY SURVEYORS FILE DATA
DO NOT REMOVE FROM OFFICE

LEGEND
o Fd. 5/8" Iron rod
● Set 5/8" Iron rod

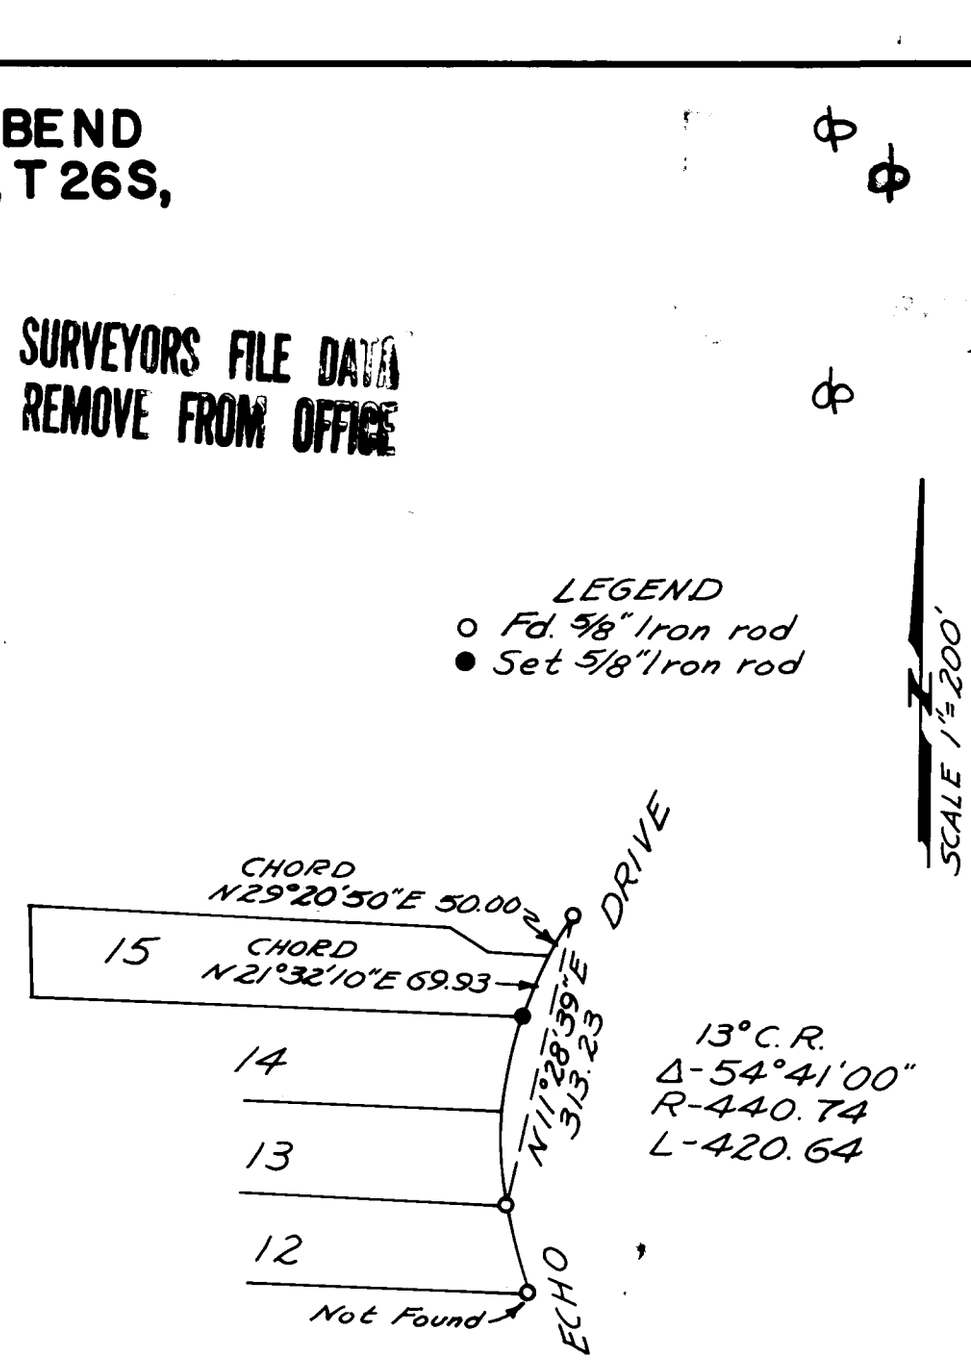

REGISTERED
PROFESSIONAL
LAND SURVEYOR

OREGON
JULY 30, 1976
ROBERT L. DOLAN
1976

File No. 58/211-2