M 96-20

FILED
RECEIVED

MAR 22 1984

COUNTY SURVEYOR
DOUGLAS COUNTY, ORE.

OREGON CORNER RESTORATION FORM

Section 26 Township 20S Range 9W

County Douglas Date 3-05-84

Corner Designation

East 1/16 Corner
Section 26

26
—
35

___Condition Report Only
___Not Found
___Renewed
___Unrecorded
x Surveyed In
___Referenced Out

Previous Renewals/Surveys, etc. None

Monument(s) & Accessories Found: (Condition and Source)

Monument Detail

Sketch

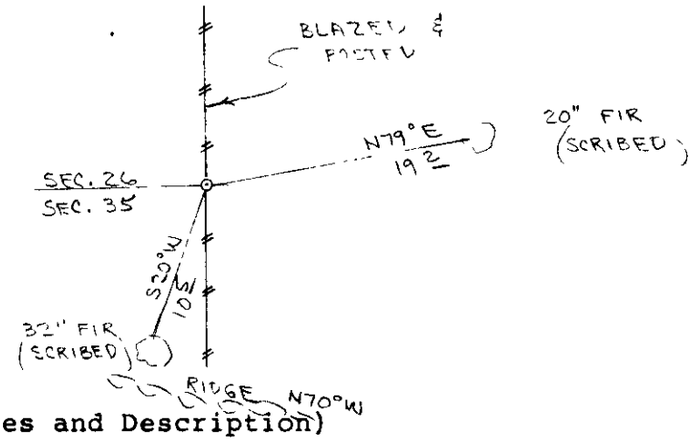

Monument Set (Procedures and Description)

Set 2" x 36" Aluminum pipe and cap. Cap stamped S-T-R, date and P.L.S. No. 1039. Buried purple magnetic marker under 36" pipe. See filed survey for survey procedures.

New Accessories

20" Fir, N79E, 19.2' (Scribed/Painted Red/Brass Washer)
32" Fir, S20W, 10.5' (Scribed/Painted Red/Brass Washer)
Set metal fence post, with land survey monument sign wired to, beside aluminum pipe.

Location & Comments

Corner lies on North slope about 80 feet North of ridge. Ridge bears N70W & S70E. Corner lies in 100-120 year old green timber.

Compass Declination 20½
Firm/Agency Roberts Surveying Inc.
Address 29 West 29th St. Eugene, Oregon 97405
Party Chief Ted Baker
Notes Stu Duce
Witness Buzz Moisan

Surveyor's Seal

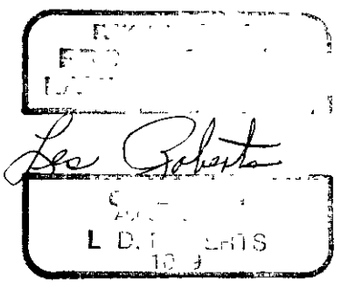

ok Jim C.S. File No. 58/220-23K