REGISTERED
OREGON
LAND SURVEYOR
Wilford N. Haines
MAY 7, 1948
WILFORD N. HAINES
239

PRELIMINARY FILING
ORIGINAL BEING PROCESSED
BY DEVELOPER
DATE SUBMITTED 11/12/8

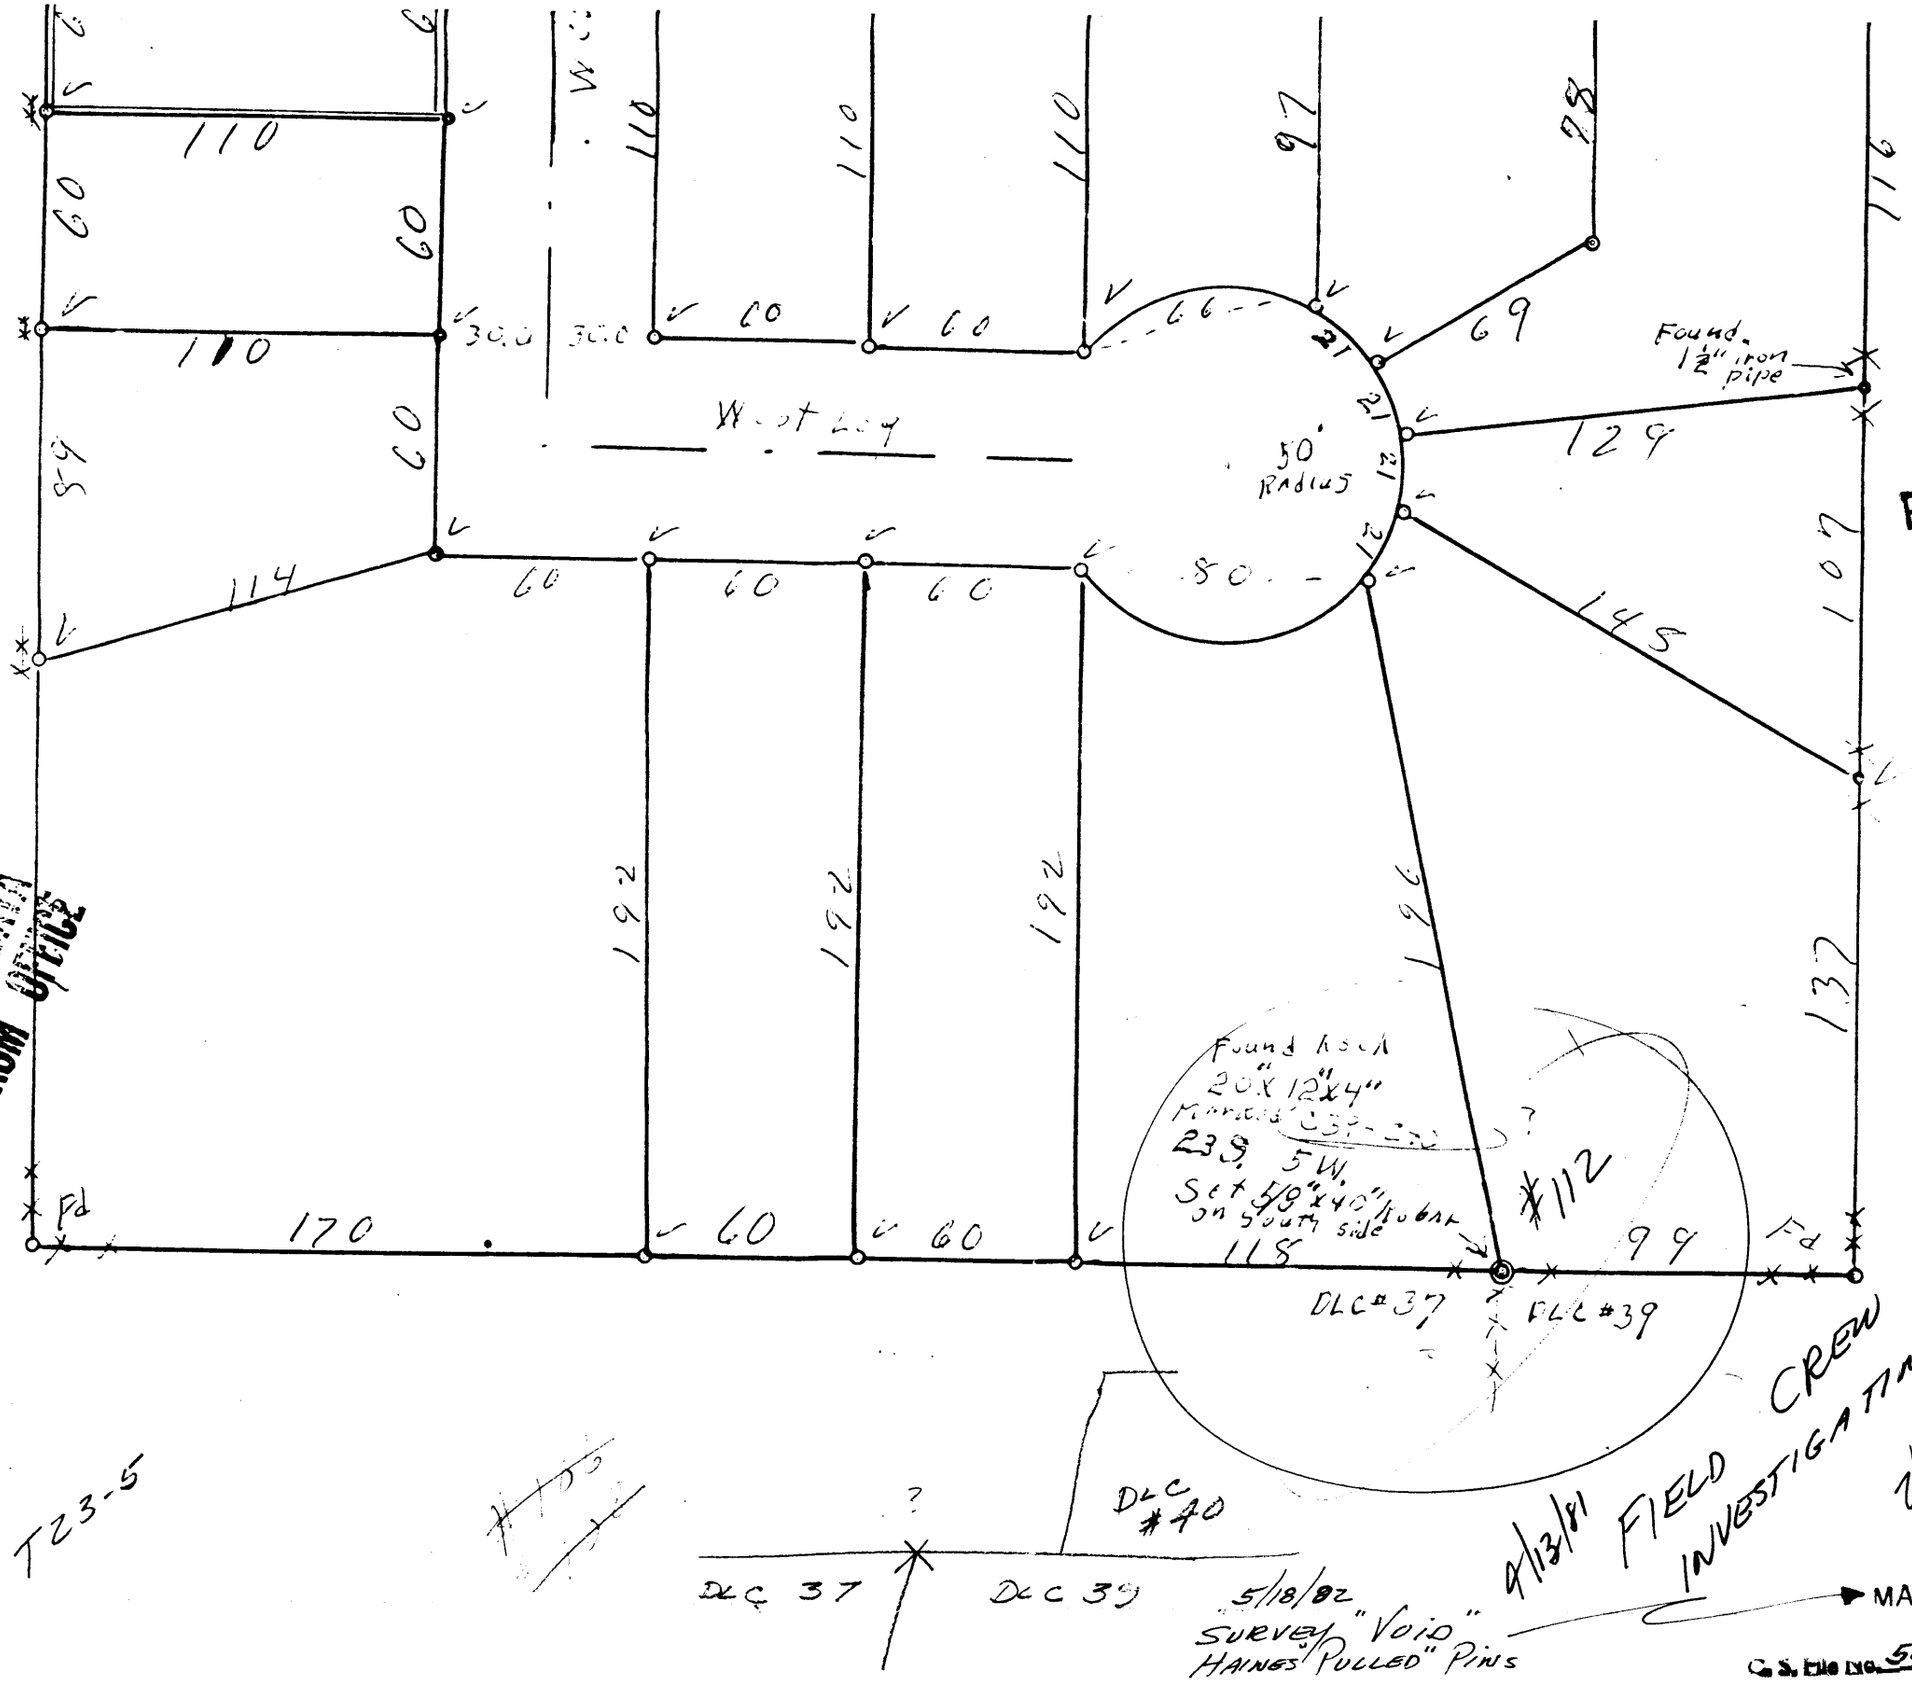

COUNTY SURVEYORS FILE DATA
DO NOT REMOVE FROM OFFICE

4/13/81 FIELD CREW INVESTIGATING (PER ED)

11/2/81 ED SUGGESTED GOING AHEAD & PUTTING HAINES CORNER ON PROPOSED AS IS. J.

J. CS 58/229 (FOR CORN REC

5/18/82 SURVEY "VOID" HAINES "PULLED" PINS

MAP FILE P-14

C. S. File No. 58/229-43