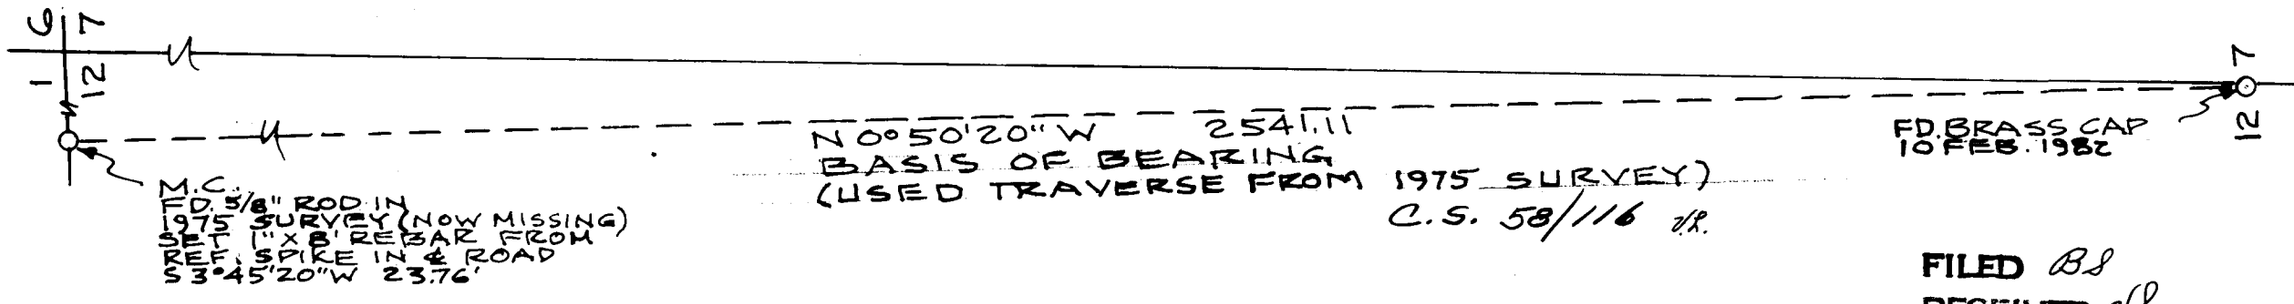

88493 HWY. 101
FLORENCE OR.

REGISTERED
PROFESSIONAL
LAND SURVEYOR

Robert A. Manseth

OREGON
SEPTEMBER 23, 1977
ROBERT A. MANSETH
1258

FILED BS
RECEIVED
FEB 16 19
COUNTY SURVEYOR
DOUGLAS COUNTY, ORE.

COUNTY SURVEYORS FILE DATA BS
DO NOT REMOVE FROM OFFICE

PROPERTY SURVEY FOR
DAVIDSON INDUSTRIES

NE1/4 SEC. 12, T20S, R12W, W.M.

SCALE 1" = 100' 10 AUG. '81

RE-SUBMITTED 10 FEB '82

NOTE: USE 23°± MAGNETIC DECLINAT
TO MATCH THESE BEARINGS

SURVEY MONUMENT TO BEARING TREE

A.	17"	SPRUCE	N65°E	10.64'
B.*	8"	WILLOW	S43°E	12.23'
	11"	HEMLOCK	S38°W	6.80'
	9"	SPRUCE	S51°E	18.56'
C.	10"	SPRUCE	N65°W	21.23'
	12"	SPRUCE	N85°E	20.67'
D.	15"	SPRUCE	N64°W	14.28'
	8"	SPRUCE	S64°E	19.79'
E.	15"	SPRUCE	S80°W	19.09'
	18"	SPRUCE	S73°E	32.08'
F.	6"	SPRUCE	S23°E	31.64'
	9"	SPRUCE	S4°W	31.08'
G.	7"	SPRUCE	S85°E	7.52'
	8"	SPRUCE	N18°W	11.43'
H.*	14"	ALDER	N10°E	3.85'
	6"	SPRUCE	S15°E	10.96'

* TWIN TRUNK

DIST. ARE TO CTR. OF TREE - MKD. BY SPIKE

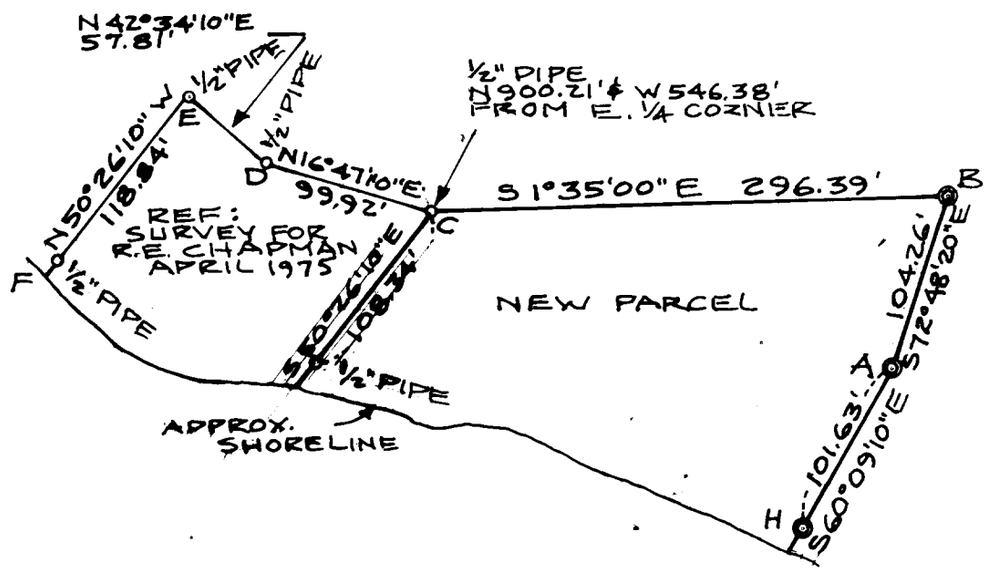

○ FOUND SURVEY MONUMENT

◎ SET 5/8" REBAR x 30" LONG. W/PLASTIC CAP

C.S. File No. 58/266