GOVERNMENT CORNER RESTORATION FORM

Township 27S Range 7W Sec. 19 County DOUGLAS

State OR Date 5-6-82 No.

Corner Designation

T27S

R 8 W	13	18	R 7 W
	24	19	

✓ Condition Report Only
___ Not Found
___ Renewed
___ Unrecorded
___ Surveyed In
___ Referenced Out

Previous Renewals

Monument(s) Found: (Condition and Source)

FD. UNRECORDED 3/4" x 30" IP LOOSLEY SET PROTRUDING 12" OUT OF GROUND.

MONUMENT DETAIL

Accessories Found:


FD. 19" FIR STUMP WITH "W" NAIL & WEYERHAEUSER BT TAG, BEARS S 32°E 12.2 FT.

FD. 12" HEMLOCK STUMP WITH "W" NAIL & WEYERHAEUSER BT TAG BEARS N 40° W 8.6 FT. - THIS IS [illegible] AN ORIG. BT, HOWEVER THERE IS NO FACE OR SCRIBING VISIBLE.

FD. 33" FIR STUMP WITH "W" NAIL & WEYERHAEUSER BT TAG, BEARS S 82° W 13.4 FT.

RENEWAL

Monument Set (Procedure and Description)

Monument Detail

New Accessories

Sketch of Monument, Acessories, and General Area

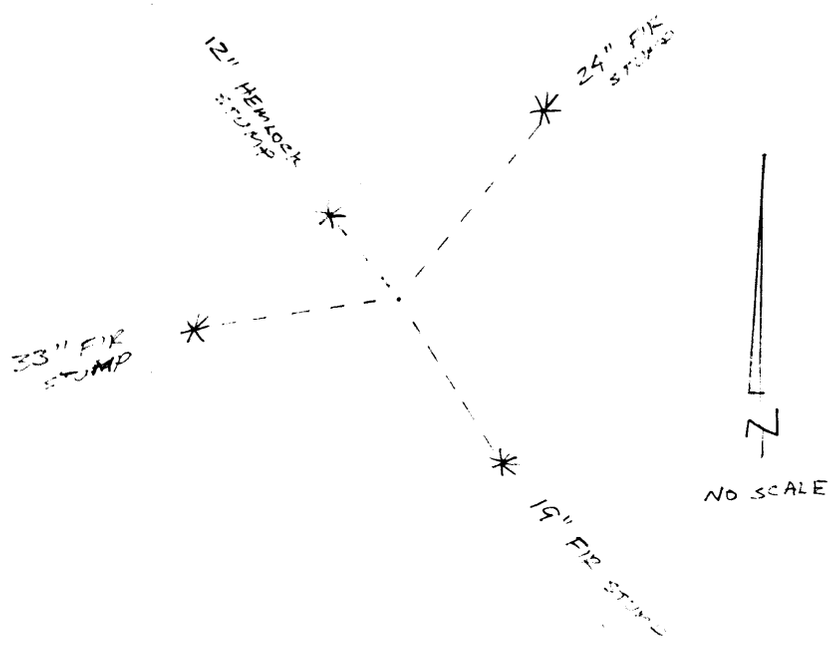

Location & Comments

Comp. Declin. 19°E
Agency DCSO
Party Chief GREGORY E QUIBELL
Notekeeper Gregory E. Quibell
Witnesses JOHN POWELL

Surveyor's Seal