COUNTY SURVEYORS FILE DATA
DO NOT REMOVE FROM OFFICE

SURVEY FOR DEED DESCRIPTION IN THE NW 1/4 SECTION 21, T.25S., R.7W., W.M., DOUGLAS COUNTY, OREGON

FILED CMO
RECEIVED
MAY 22 1985
COUNTY SURVEYOR
DOUGLAS COUNTY, ORE.
CMO

FOR: JAMES E. AND MABEL A CUSTER

BY: ROBERT L. DOLAN
RT. 1, BOX 1820
SUTHERLIN, OR. 97479

Legend:
- ○ FD. 1/2" IRON ROD
- ● SET 5/8"x30" IRON ROD W/CAP (LS 1076)

DATE: APRIL 1985
SCALE: 1"=50'

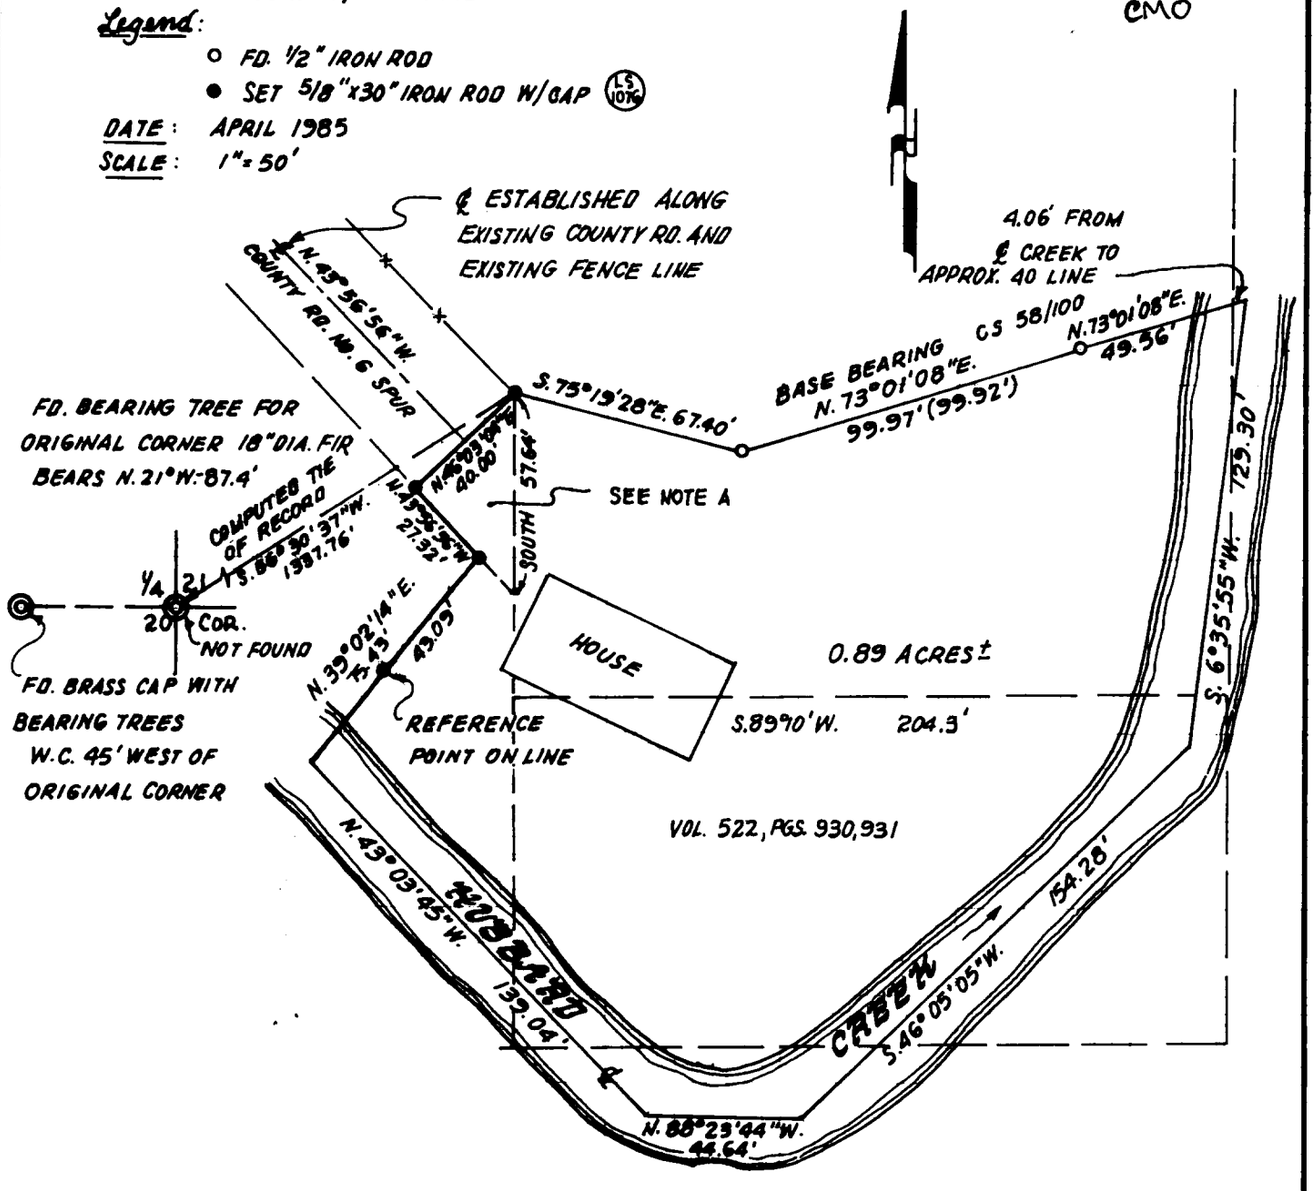

NARRATIVE: SURVEY FOR DEED DESCRIPTION FOR PROPERTY LINE AGREEMENT WITH ADJACENT PROPERTY OWNERS.

THE OLD COUNTY ROAD HAS BEEN ABANDONED, REFER TO DEED NO. CCJ VOL.51, PG.206

OTHER DEED REFERENCES, NO. 76-13021, NO. 76-13577 AND NO. 73-12204

INSTRUMENTS: THEODOLITE, DISTANCE METER

NOTE A: THIS PORTION OF COUNTY RIGHT-OF-WAY TO BE ABANDONED.

REGISTERED PROFESSIONAL LAND SURVEYOR
Robert L Dolan
OREGON
JULY 30, 1976
ROBERT L. DOLAN
1076

C.S. File No. C.S. 58/279-5