M 96-24

FILED
RECEIVED BS
MAR 28 1984
COUNTY SURVEYOR
DOUGLAS COUNTY, ORE.

OREGON CORNER RESTORATION FORM

Section 21 Township 22S Range 9W

County Douglas Date 9-14-83

Corner Designation

South 1/16 Corner
Section 21

21 | 22

x Condition Report Only
___ Not Found
___ Renewed
___ Unrecorded
___ Surveyed In
___ Referenced Out

Previous Renewals/Surveys, etc. Wofford, Rogers and Chatters Cadastral Survey dated 1973-1979. Harvey Wofford's Cadastral Survey dated 1983 (Unapproved).

Monument(s) & Accessories Found: (Condition and Source)

Found 1983 B.L.M. Brass Cap set firmly in ground.
24" Fir, S15W, 54.5'(Scar Vis.), 1975 BT. Rec. S14W, 54.3'
36" Fir, S38E, 14.5'(Scribe Vis.), 1983 BT. Rec. S40E, 14.5'
Erroneously set B.L.M. Brass Cap, 1975, bears S 18° 05' 29" W, 29.06'. 1975 B.L.M. Brass Cap has been removed and reset in the correct position. The 1975 date has been filed off and brass cap restamped 1983.

Monument Detail

Sketch

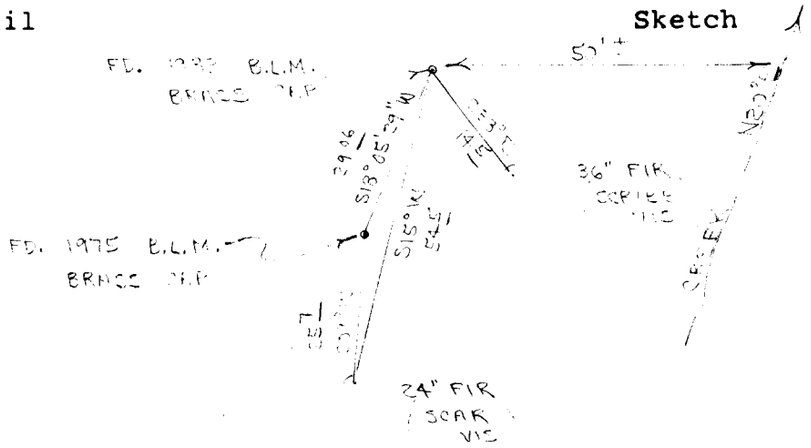

Monument Set (Procedures and Description)

New Accessories

None

Location & Comments

Corner lies on East slope about 50' West of creek. Creek bears N20E

Compass Declination 20½

Firm/Agency Roberts Surveying Inc.

Address 29 West 29th St.
Eugene, Oregon 97405

Party Chief Ted Baker

Notes Stu Duce

Witness

Surveyor's Seal

REGISTERED
PROFESSIONAL
LAND SURVEYOR

Leo Roberts

OREGON
AUGUST 22 1975
L. D. ROBERTS
1029

C.S. File No. 58/280(N) AA

0 of 11