NARRATIVE:

SURVEY TO SHOW RELATIONSHIP OF DEED LINES AND FENCE LINE AND TO ESTABLISH AND DESCRIBE QUIT CLAIM LINE. FIELD WORK BY GREG LANG. COMPUTATIONS BY D. BENTZ. DRAFTING BY D. HOPKINS.

BASE BEARING: SOLAR OBSERVATION.

LEGEND:

● - SET 5/8" x 30" IRON ROD WITH CAP MKD. "BHW, INC."

o - FOUND MONUMENT AS NOTED

FILED BS
RECEIVED BS

MAR 11 1983

COUNTY SURVEYOR
DOUGLAS COUNTY, ORE.
BS

SCALE:
1" = 1000'

FEBRUARY
1983

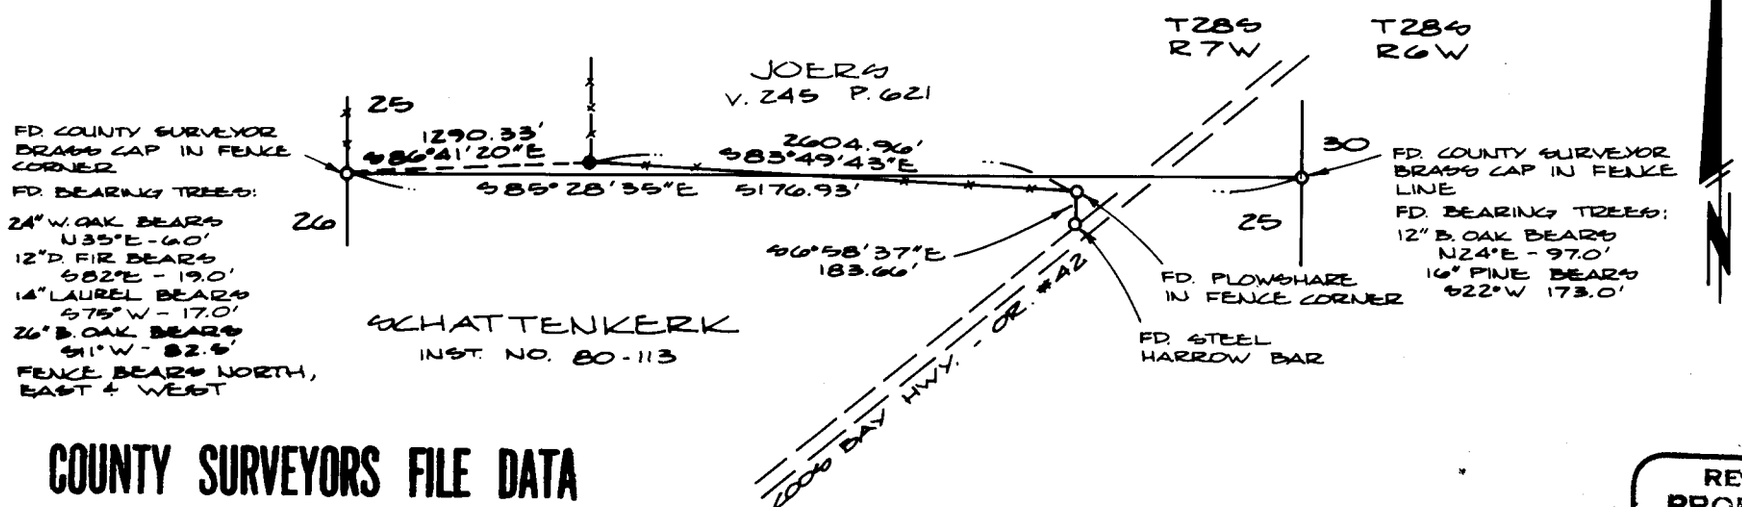

COUNTY SURVEYORS FILE DATA
DO NOT REMOVE FROM OFFICE

REGISTERED
PROFESSIONAL
LAND SURVEYOR
OREGON
JULY 14, 1972
DONALD A. BENTZ
1359

SURVEY IN SECTION 25, T28S, R7W, W.M.

FOR: JACK JOERS & AL SCHATTENKERK
FOR QUITCLAIM PURPOSES

BY: DONALD A. BENTZ, SURVEYOR, INC.,
P.O. BOX 901, WINCHESTER, OR

File No. 58/282-1