FILED BS
RECEIVED BS
FEB 14 1984
COUNTY SURVEYOR
DOUGLAS COUNTY, ORE.
BS

SURVEY TO SET PROPERTY CORNERS
in the
N. W. quarter of Section 33, T. 30 S., R. 2 W., W. M.
February 1984 Scale: 1"=20'

For: Hubert & Verla Stone
By: Baughman Technical Services, Inc.
P.O. Box 222, Roseburg, OR. 97470
Tel. No. 673-0966

Narrative: The survey was performed to monument that property described in Inst. No. 82-12046, and that property described in Exhibit A of Case No. E 82-2630 Circuit Court of Douglas County. While performing the survey it was discovered that the Section corner tie in the Exhibit was in error. The S. 89°49'05" W., 71.93 feet as contained in the exhibit should have read S. 89°49'05" W., 75.00 feet as shown on M 91-21. This information has been forwarded to the attorney for the plaintiff for correction of the judgement exhibit.

Monuments were found as shown and as originally recorded in M 91-21. That recording aslo furnished the basis of bearings for the survey. The work was performed by Kristian DeGroot using a Lietz TM 20-C and 100 foot steel tape.

COUNTY SURVEYORS FILE DATA
DO NOT REMOVE FROM OFFICE

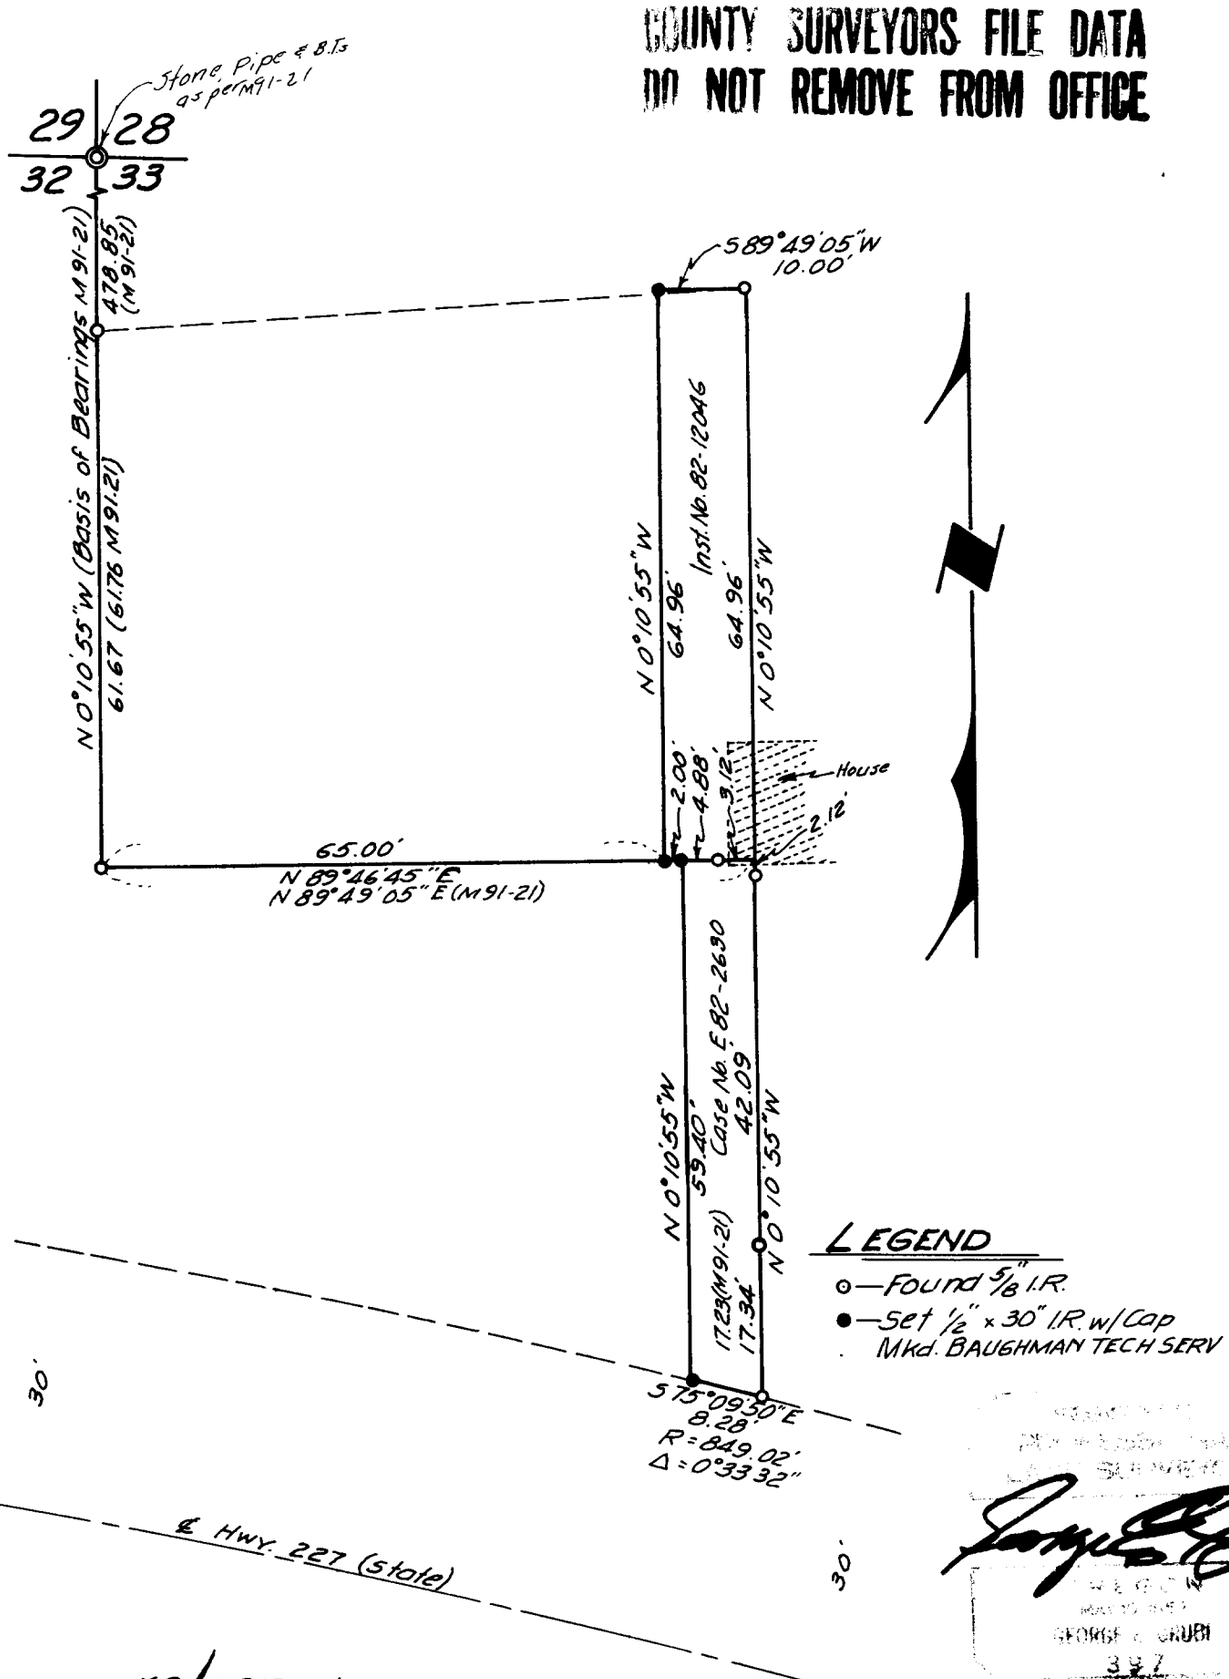

LEGEND
⊙—Found 5/8" I.R.
●—Set 1/2" x 30" I.R. w/Cap Mkd. BAUGHMAN TECH SERV

GEORGE R. GRUBB
387

C. S. File No. 58/287-4