M 96-46

FILED
RECEIVED BS
APR 26 1984
COUNTY SURVEYOR
DOUGLAS COUNTY, ORE.

OREGON CORNER RESTORATION FORM

Section 34 **Township** 19S **Range** 9W

County Douglas **Date** 04-03-84

Corner Designation

N.E. Corner
Section 34

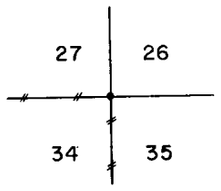

___ Condition Report Only
___ Not Found
x Renewed
___ Unrecorded
___ Surveyed In
___ Referenced Out

Previous Renewals/Surveys, etc. Tillman and Brooks Cadastral Survey dated 1957-1958.

Monument(s) & Accessories Found: (Condition and Source)

Found 1957 B.L.M. Brass Cap laying on creek bank. Brass Cap had been washed away by Beaver Creek.
24" Alder, S10E, 19.8'(Bark Scribed), 1899 BT. Rec. S14E, 19.3'
54" Cedar, S19½W, 81.2'(Scar Vis.) , 1957 BT. Rec. S19½W, 81.2'
20" Alder set in 1899 and found in 1957 is now destroyed.
22" Alder bearing N49E and set in 1957 is now destroyed.
18" Alder bearing N71W and set in 1957 has been up-rooted by creek.

Monument Detail

Sketch

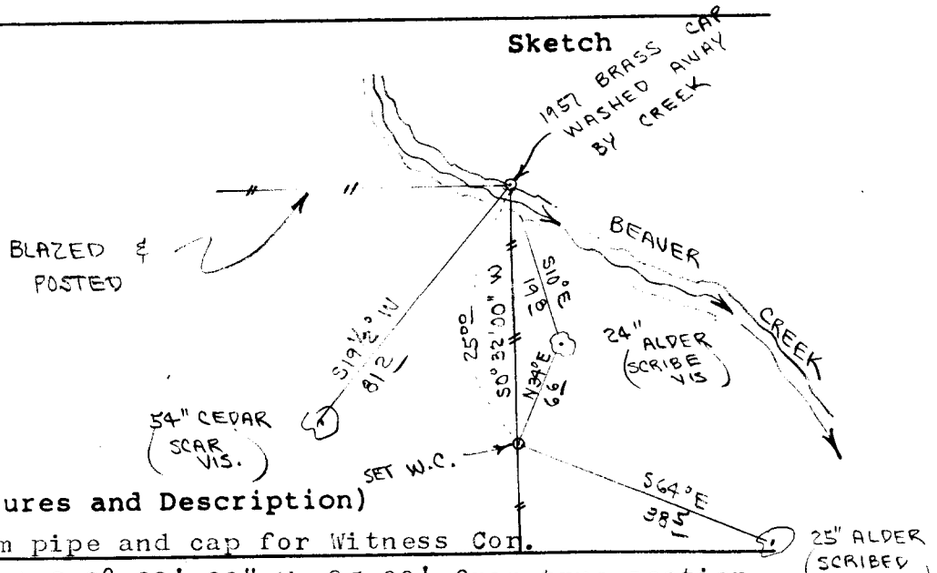

Monument Set (Procedures and Description)

Set 2" x 30" Aluminum pipe and cap for Witness Cor. Witness Corner was set S 0° 32' 00" W, 25.00' from true section corner, see sketch. See filed survey in Section 34 for survey procedures. Buried purple magnetic marker under 30" aluminum pipe.

New Accessories

25" Alder, S64E, 38.5' (Bark Scribed/Painted/Brass Washer)
24" Alder, N34E, 6.6' (BarkScribed /Painted/Brass Washer)
Set metal fence post beside brass cap. Wired survey attention sign to fence post.

Location & Comments

Surveyor's Seal

Compass Declination 20½
Firm/Agency Roberts Surveying Inc.
Address 29 West 29th St. Eugene, Oregon 97405
Party Chief Les Roberts
Notes Ted Baker
Witness Stu Duce

REGISTERED PROFESSIONAL LAND SURVEYOR
Les Roberts
OREGON
AUGUST 22, 1975
L. D. ROBERTS
1039

#35
(3)

C.S. File No. 58/293 - 4C

OK Jem