"H"

FILED
RECEIVED 2/8
APR 11 1984
COUNTY SURVEYOR
DOUGLAS COUNTY, ORE.

OREGON CORNER RESTORATION FORM

Section 4 Township 21S Range 9W

County Douglas Date 3-23-84

Corner Designation

S.E. 1/16 Corner
Section 4

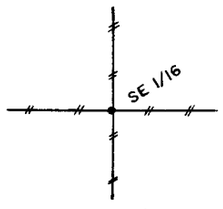

___Condition Report Only
___Not Found
___Renewed
___Unrecorded
___Surveyed In
x Referenced Out

Previous Renewals/Surveys, etc. See Survey M90-36 by Roberts Surveying dated December 20, 1982.

Monument(s) & Accessories Found: (Condition and Source)

Found 1½ x 36" Iron Pipe and Brass Cap set in Survey M90-36.
17" Hemlock, N81E, 138.0'(Scribe Vis.), 1982 BT. Rec. N81E, 138.0'
52" fir , S15E, 91.5'(Scribe Vis.), 1982 BT. Rec. S15E, 91.5'

Corner is in subgrade of new logging road. I set 2 new R.P.'s as noted below.

Monument Detail

T21S R9W
SEC. 4
SE1/16 + COR
1982
P.L.S. 1039

Sketch

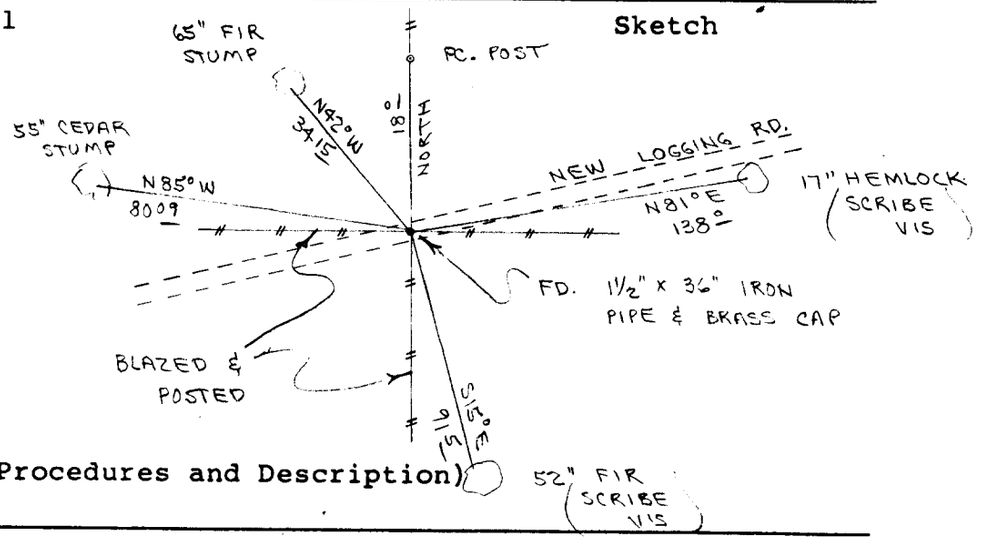

Monument Set (Procedures and Description)

New Accessories

Set 5/8" x 9" iron rod in root collar of 55" Cedar Stump. N85W, 80.09' to iron rod.
Set 5/8" x 13" iron rod in top of 65" Fir Stump. N42W, 34.15' to iron rod. Metal fence post, with land survey monument sign wired to, bears North 18.0'

Location & Comments

Surveyor's Seal

Compass Declination 20½

Firm/Agency Roberts Surveying Inc.

Address 29 West 29th St. Eugene, Oregon 97405

Party Chief Les Roberts

Notes

Witness Marion Hunter

REGISTERED PROFESSIONAL LAND SURVEYOR
Les Roberts
OREGON
AUGUST 22, 1975
L. D. ROBERTS
1039

C.S. File No. 58/293-9