

T 225

RTW RLW

12 7

13 18

CORNER LOT of RECORD

SEE REN # 7225
42
54722-7

FOUND:

A 6" x 6" x 1" "X" CHISELED INTO A COULDER
FROM WHICH:

A 14" D.F. BEARS N62E, 18.0' DIST.

WITH HAINES WASHER ATTACHED
AND WITH VISIBLE BLAZE. BLAZE
IS FADING SLOW NOT CHISELED "X".

TREE HAS A BEARING TREE TAG
THAT READS "SG2W; 17.8, MARTIN
B/17/56". WE OPEN AND FIND
VISIBLE "BT"

A 12" D.F. THAT BEARS N51W, 2.6' DIST.

TREE IS ALIVE AND SHOWS GOOD
BLAZE. TREE HAS A BEARING TREE
TAG THAT SAYS "SG0E, 2.6' DIST.

A 15" D.F. THAT BEARS S51W, 25.3'
DIST. TREE IS ALIVE AND WELL AND
SHOWS BLAZE. ALSO HAS HAINES

NOTED ✓

C.S. File No. 59/8-17

4/14/76

(2)

WASHER AND TAG THAT SAYS
"N 53° E, 25.6"

A IS D.F. BEARS S 41° W, 35.1' DIST
TREE IS ALIVE AND BLAZE FALES
EAST, NOT CHISELED "X"


CORNER NOT OF RECORD

COMPASS DEK.

20° E


A. Victor Congie
GARY L. CANBLITZ
PETE L. EARLE

NOTE: INFORMATION GIVEN IN PEN.
* A2 DOESN'T MATCH CONDITION
ACTUALLY AT THE CORNER.

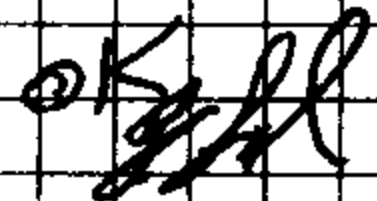OK 

DIETZEN NO. 385-6

C. S. File No. 59/8-17

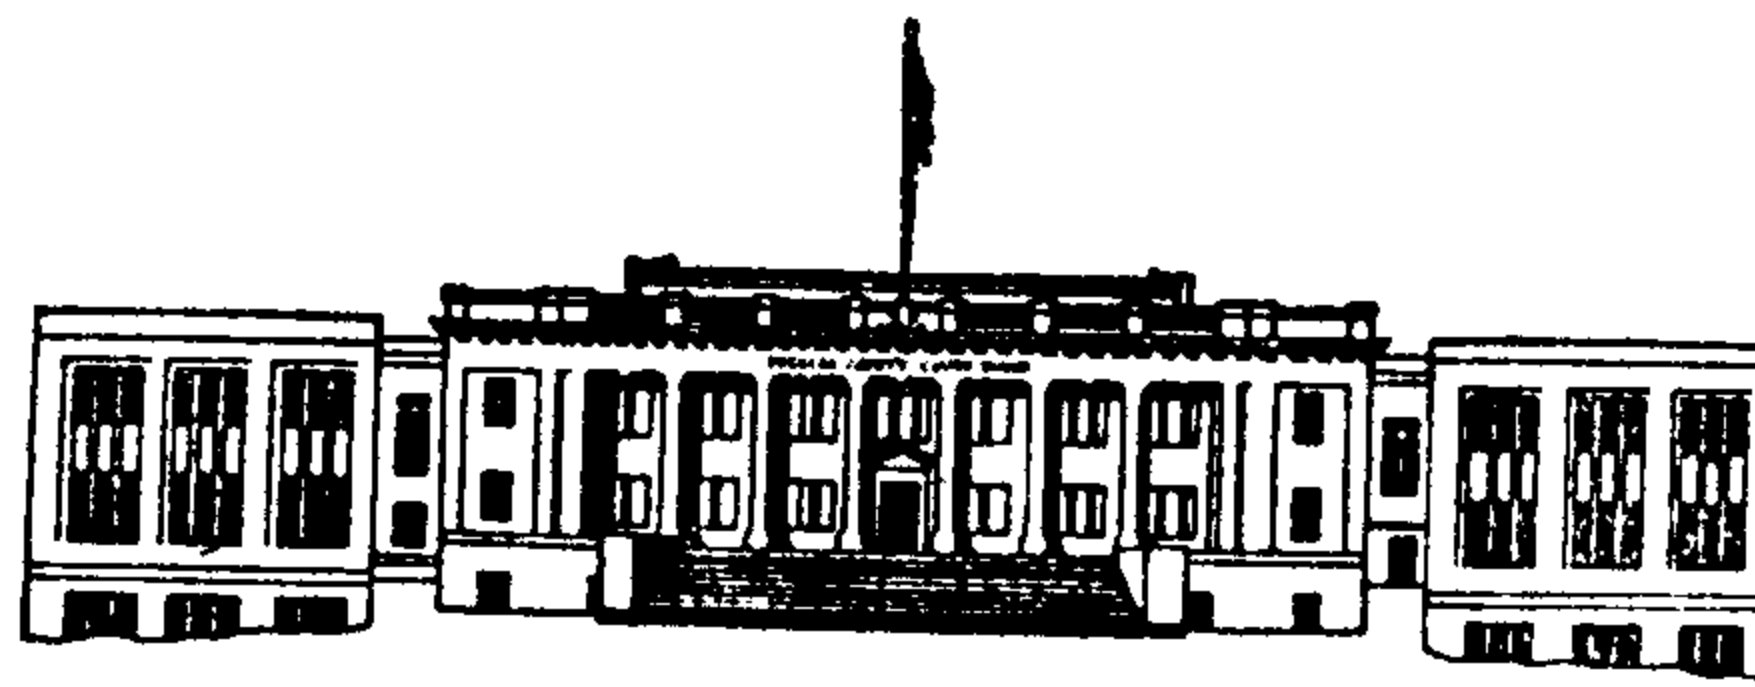

COUNTY OF DOUGLAS
OFFICE OF THE SURVEYOR
ROSEBURG, OREGON 97470

May 25, 1976

Mr. Wilford N. Haines
Star Route 38 Box 2
Drain, OR 97435

Dear Mr. Haines:

Recently a corner renewal crew from this office was working in the vicinity of the corner common to sections 7 and 18 in Township 22 South, Range 6 West and sections 12 and 13 in Township 22 South Range 7 West. Our notes for this corner included the original government survey notes and the marking of a proportioned corner taken from your survey for Chester Sweringen and Harold Woolley dated 1956 (Map file #M3-22).

In the approximate location for this corner as determined from aerial photos and topographic maps, our crew found a large chiseled "X" in bedrock and four bearing trees. The conditions we find at this apparent corner location appears to have no relationship to the monument and bearing trees as noted on the enclosed copy of our corner renewal records.

Any assistance you can give us in resolving this situation will be appreciated.

Sincerely yours,

Gary L. Langlitz

Gary L. Langlitz
Survey Supervisor

GL:gt

encl.

NO REPLY