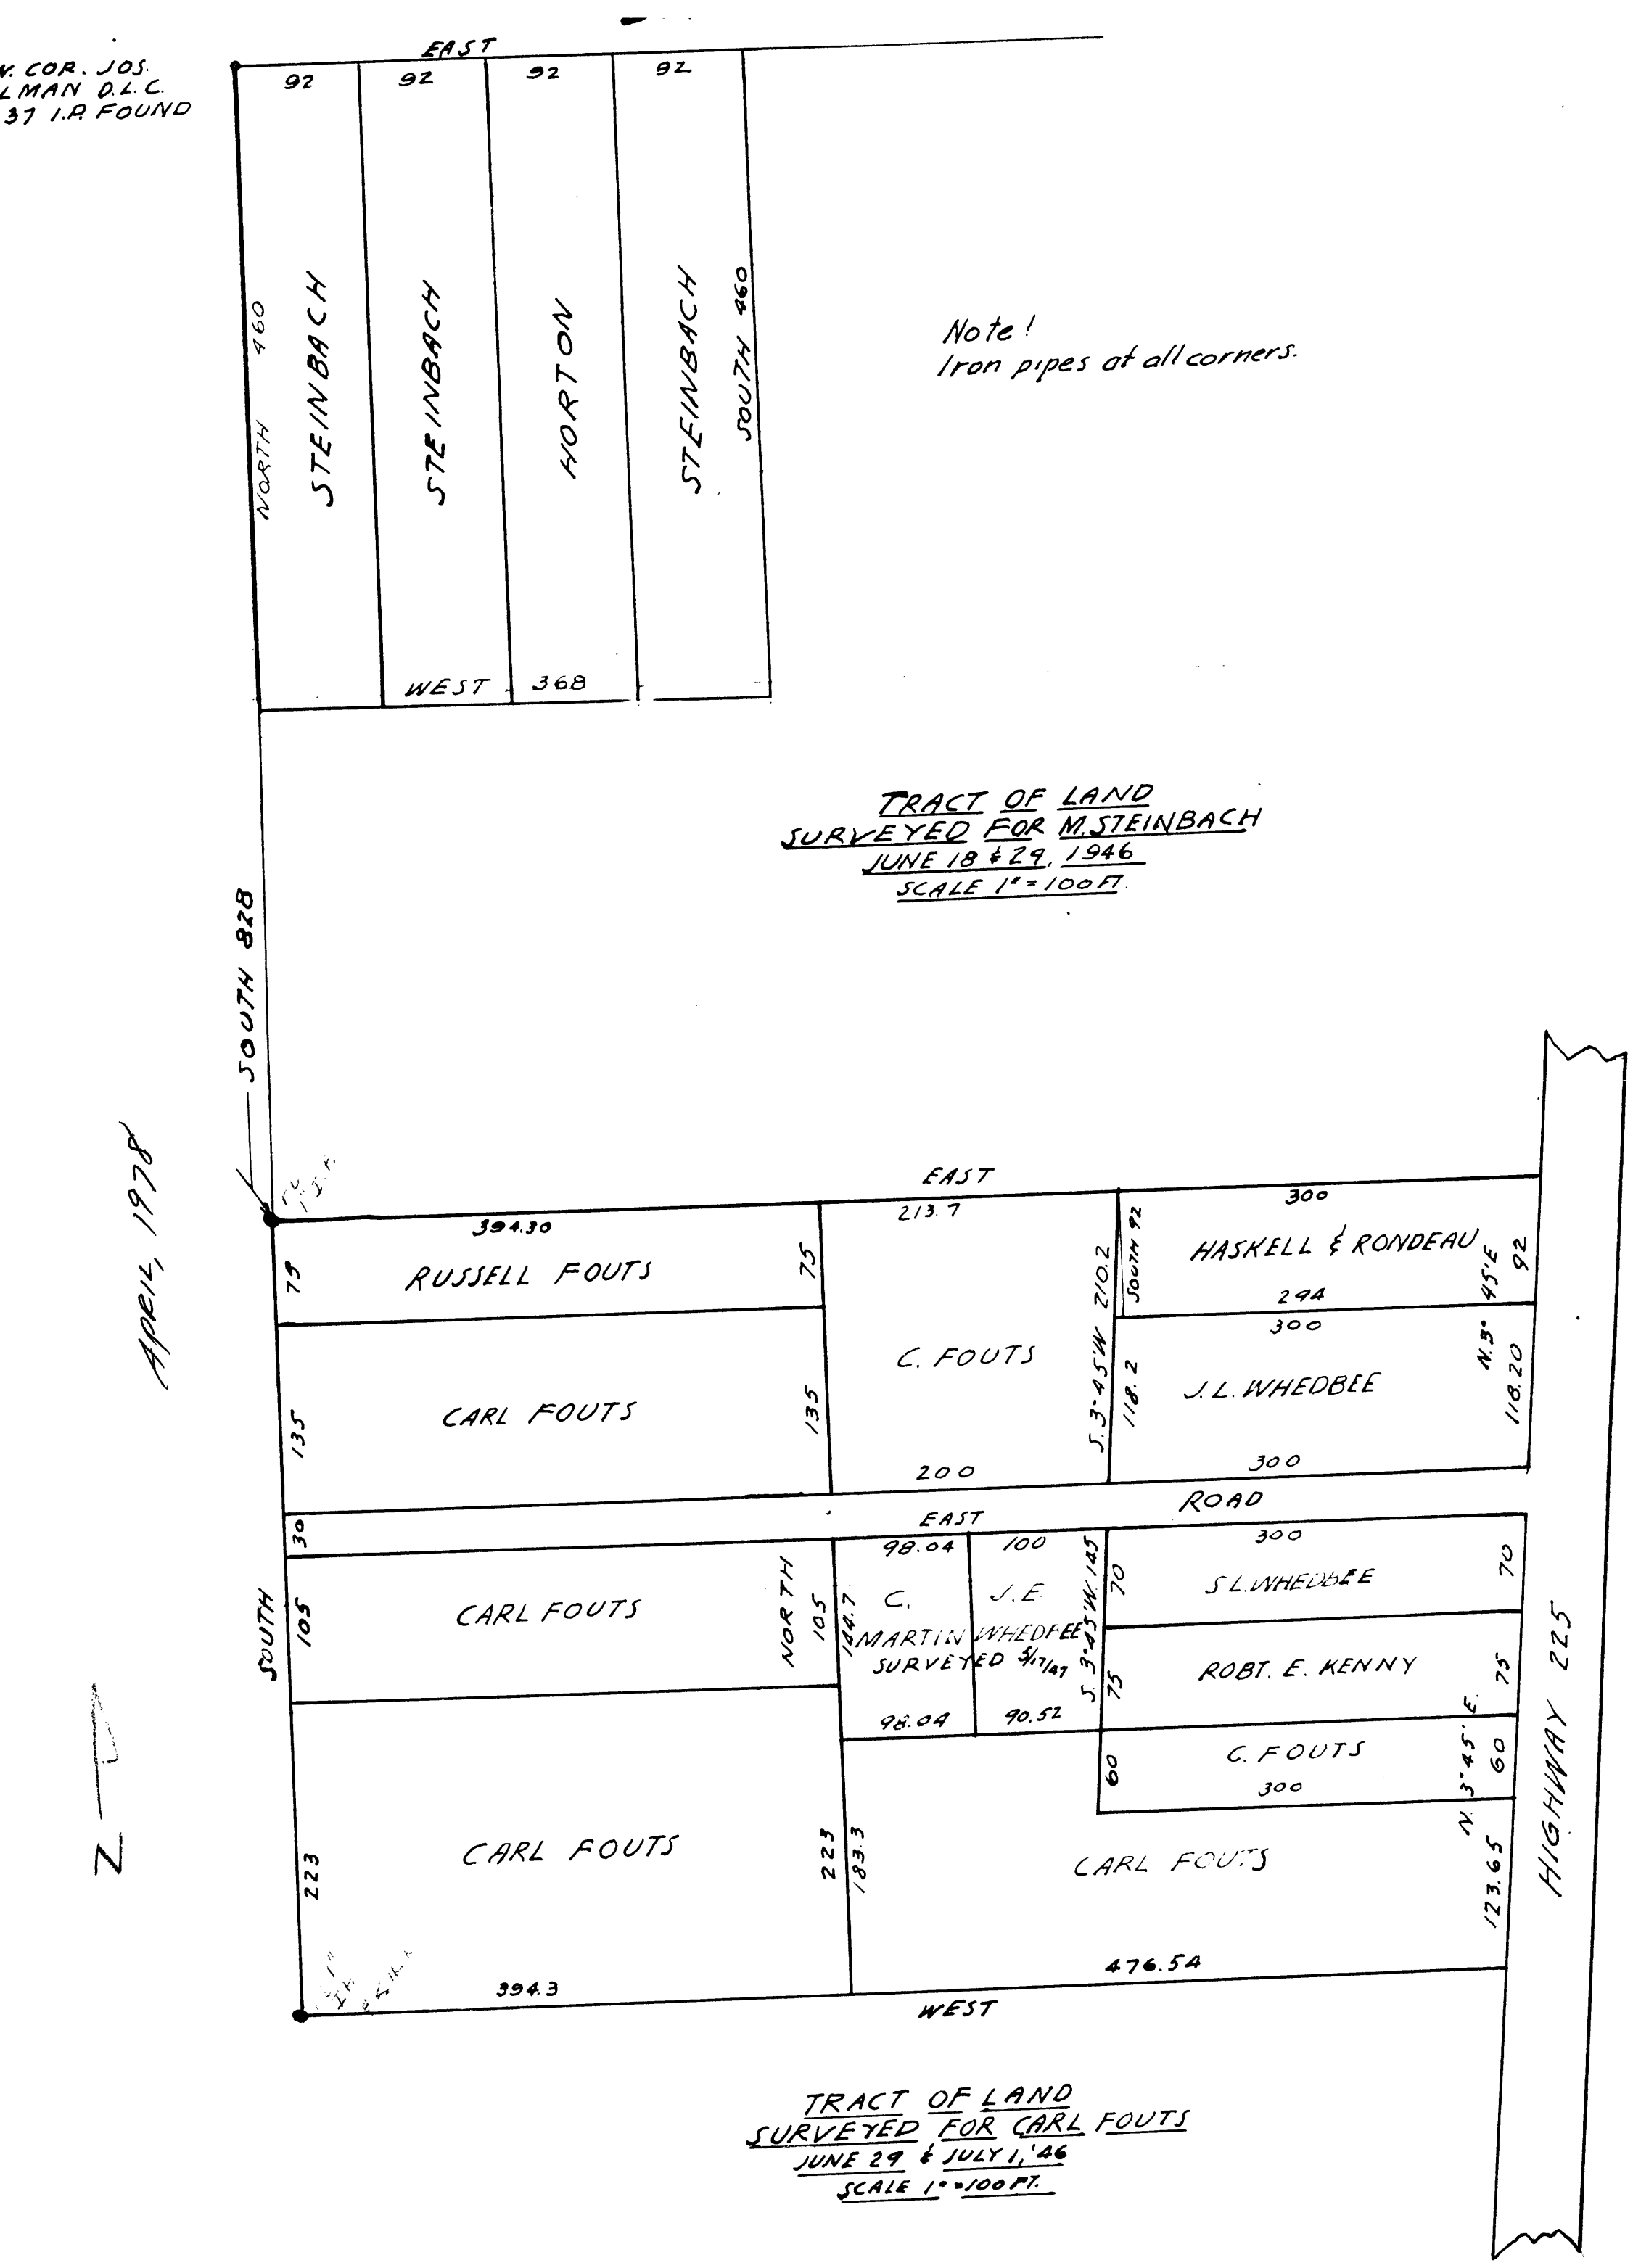

Surveyed by W. W. Elmer
Registered Prof Engr
W. W. Elmer

C.S. FILE 40/172
M 13-10

C. S. File No. 60/1-1