

1/4 COR

DATE: 2-19-81

S12 * S7

R9W R8W

T315

Condition Report Only
 Not Found
 Renewed
 Unrecorded
 Surveyed In
 Referenced Out

Previous Renewal #'s 1962 BLM

Monument(s) Found: (Condition and Source) FD. 1962 BLM

BRASS CAP IN GOOD CONDITION BURIED IN

THE GROUND APPROX. 8" CAP IS STAMPED:

1/4 S12 * S7 ^{T315} R9W R8W 1962

Accessories Found: (Condition and Source)

FD. STUMP OF ORIG 42" NOW 47" FIR BT WITH

BLM BT TAG BEARS WEST 13.2 FEET TO

THE FACE.

(Sec 7)

FD. STUMP OF ORIG. 48" FIR BT WHICH

HAS ROLLED OVER AND SLID DOWN THE

HILL ALMOST ON TOP OF THE CAP.

#19 T31-8 ✓

#163 T31-9 ✓

C.S. FILE NO. 61/19-7

Page of

C

RENEWAL

Monument Set: (Procedure and Description) NA

New Accessories: (Description) SET BOAT SPIKE

IN TOP OF ORIG. SEC. 12 BT. STUMP WHICH
IS NOW 47" SPIKE BEARS WEST 145 FT

SET BOAT SPIKE IN TOP OF 48" FIR STUMP
WHICH BEARS N 38° E 66² FT. BOTH STUMPS

HAVE NEW BT TAGS - NO TREE SUITABLE FOR
SCRIBING ARE IN THE VICINITY

Location and Comments: 19° E Compass Declination

DCSO Agency

GREG QUIBELL Party Chief

August E. Quibell Notekeeper

DEBBIE STEWART Witnesses

OK
[Signature]

Rm. 122 - COURTHOUSE
ROSEBURG, OR 97470

DOUGLAS COUNTY SURVEYOR


PH: 672-3311
EXT. 114

Section 7 ^{w/14} Twp. 31 Rge. 8

CORNER RENEWAL REQUEST

Date Feb. 9, 1981

Condition of Corner and Accessories: BLM 1962 brass cap still in place. Bearing trees destroyed because of logging

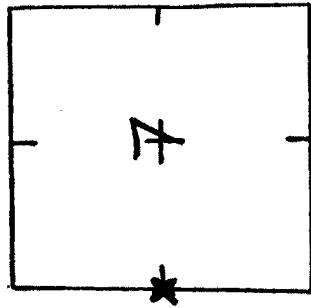

TO REACH: (Please show approximate distances, clearcuts, roads, fences, etc.) Take Hwy 42 to the 12 mile road (300 11.0) go to upper end of Elk Valley. Take 30-9 12.0 #11 then take 12.1 rd. It's approximately 1/4 mile to section line. The area is cut over Big rock painted orange in road. The cap is approximately 150 ft. North It has red flagging on it. A BT tag was also found and it's setting on a stump.

Notify immediately prior to renewal visit? Yes No

Notify following renewal visit? Yes No

Is corner in immediate danger of being lost or disturbed? Yes No

Name Jake Selby

Address BLM

Telephone _____

ADDITIONAL COMMENTS