T 28 S R 7 W

15	14
22	23

DATE: 5-9-77

___ Condition Report On
___ Not Found
___ Renewed
___ Unrecorded
___ Surveyed In
x Referenced Out

Previous Renewal #'s 69 & 215

Monument(s) Found: (Condition and Source) 1¼ INCH DIAMETER IRON ROD 6 INCHES BELOW ROAD SURFACE (SEE RENEWAL NO. 215) FROM ~~FOR~~ WHICH THE WITNESS CORNER A BRASS CAP MARKED "COUNTY SURVEYORS OFFICE T28S R7W $\frac{S15|S14}{S22|S23}$ W.C. 25 FT. S. TO 1971" BEARS N 0° 45' E 25.32 FEET.

REPLACED X 9/81

Accessories Found: (Condition and Source) SECTION CORNER ACCESSORIES REN. NO. 65

1. A D. FIR 8 NOW 26 INCH DIAMETER BEARS N 28¾° E 24.6 FEET TO FACE (25.1 FEET TO CENTER) TREE HAS WELL HEALED BLAZE.

2. A D. FIR 28 NOW 38 INCH DIAMETER BEARS N 37½° W 21.0 FEET TO FACE 22.1 FEET TO CENTER (REC. 21.1 FEET). BARK SCRIBE "BT" VISIBLE.

✓

C5 6/19-65

C. S. File No. 59/30

C. S. File No.

POSSIBLE ORIGINAL BEARING TREE

3. A B. OAK 44 INCH DIAMETER BEARS S37°E 33 1/4 FEET (REC 10 INCH DIAM. BEARS S 43°E 33.0 FEET).

BEARING TREES (PER ~~RENEWAL~~ REN. NO. 215) TO WITNESS CORNER ~~Monument Set~~: ~~(Procedure and~~ Description)

4. A D. FIR 12 NOW 11 INCHES DIAMETER BEARS S 60°E 72.9 FEET (REC. S 61°E 73.6 FEET). BLAZE PARTIALLY PITCHED OVER SCRIBING VISIBLE "23 CS".

5. A D. FIR 16 NOW 19 INCHES DIAMETER BEARS N 61½°W ~~N 61½°W~~ 108.6 FEET (REC N 64°W) BLAZE PITCHED OVER NO SCRIBING VISIBLE.

New ~~Accessories: (Description)~~

SEE ATTACHED SHEET FOR REFERENCE DRAWING.

Location and Comments:

20° EAST	Compass Declination
D C S O	Agency
L.E. MONREAN	Party Chief
Larry L. Monrean	Notekeeper
R.B. KIMBERLING	Witnesses

OK

(Doug Co. Rd. Dept. to Re-Align & Construct Rd. #108)

COUNT.

DATE: 4-9-81

T28S R7W

15	14
22	23

____Condition Report Only
____Not Found
__x__Renewed
____Unrecorded
____Surveyed In
____Referenced Out

Previous Renewal #'s _____

Monument(s) Found: (Condition and Source) _____

OVER

Accessories Found: (Condition and Source) _____

C. S. File No. 61/19-65

RENEWAL

Monument Set: (Procedure and Description) SEC. COR. NOW LIES IN A GRAVEL PULL OFF 75 FT NORTHERLY OF NORTH EDGE OF PAVEMENT STONE IS APPROX 16" IN THE GROUND.

New Accessories: (Description) _____

Location and Comments: _____

Compass Declination
Agency
Party Chief
Notekeeper
Witnesses

T 28 S R 7 W

15	14
22	23

DATE: 4-9-81

___ Condition Report Only
___ Not Found
X Renewed
___ Unrecorded
___ Surveyed In
___ Referenced Out

Previous Renewal #'s 69 & 215

Monument(s) Found: (Condition and Source)

① FD. IRON PIPE WITH BRASS CAP MARKED:

COUNTY SURVEYORS OFFICE
T 28S R 7W

15	14
22	23

W.C.
25 FT. S TO
1971

FIRMLY SET FLUSH WITH GROUND.

② FD. 1¼"×26" IRON ROD LYING BURIED AT APPROX COR. LOCATION.

Accessories Found: (Condition and Source)

① FD. 12" NOW 14" D. FIR (REN # 215) BEARS S 6 E, 7.36 FT. FROM WIT. COR. PARTIALLY HEALED WELL PITCHED-OVER SINGLE BLAZE WITH AN "8" VISIBLE.

② FD. 16" NOW 20" D. FIR (REN #215) BEARS N 64 W 108.6 FT. FROM WIT. COR. WELL HEALED SINGLE BLAZE.

③ FD. BOTH 5/8" IR'S. SET "NORTH" OF COR. FOR REF.

#240 X

C. S. File No. 6/19-65

④ DID NOT FIND EITHER 5/8" IR SET N 70°30'E FOR REF.

③ FD. 8" NOW 33" D FIR (REN. #69) BEARS N 28½°E 25± FT TO CENTER

RENEWAL

Monument Set: (Procedure and Description) USING THE TWO 5/8" IR'S SET NORTH OF THE COR FOR REF. I RESET THE 1¼"×26" IRON ROD. WHILE DIGGING THE HOLE I FIND WHAT I ASSUME TO BE THE STONE SET IN REN # 69. SINCE THIS STONE FITS BOTH

~~Mon: Appearance:~~ (~~Description~~) THE WIT. COR. AND THE TWO REF. 5/8" IR'S., I DRIVE THE 1¼"×26" IR ALONGSIDE STONE UNTIL FLUSH WITH GROUND AND END IS DIRECTLY OVER STONE.

I TIED TWO R POINTS TO COR. FOR ADDITIONAL REF. (SEE SKETCH)

Location and Comments:

(NO SCALE)

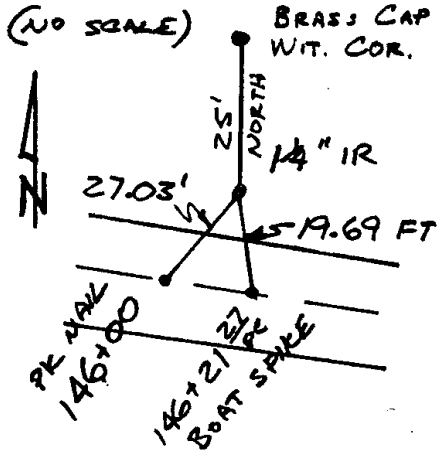

19° E. Compass Declination

DCSO Agency

GREG QUIBELL Party Chief

Gregory E Quibell Notekeeper

KAREN MOSLEY Witnesses

OK

CORNER REFERENCED OUT

T 28S R 7W

15	14
22	23

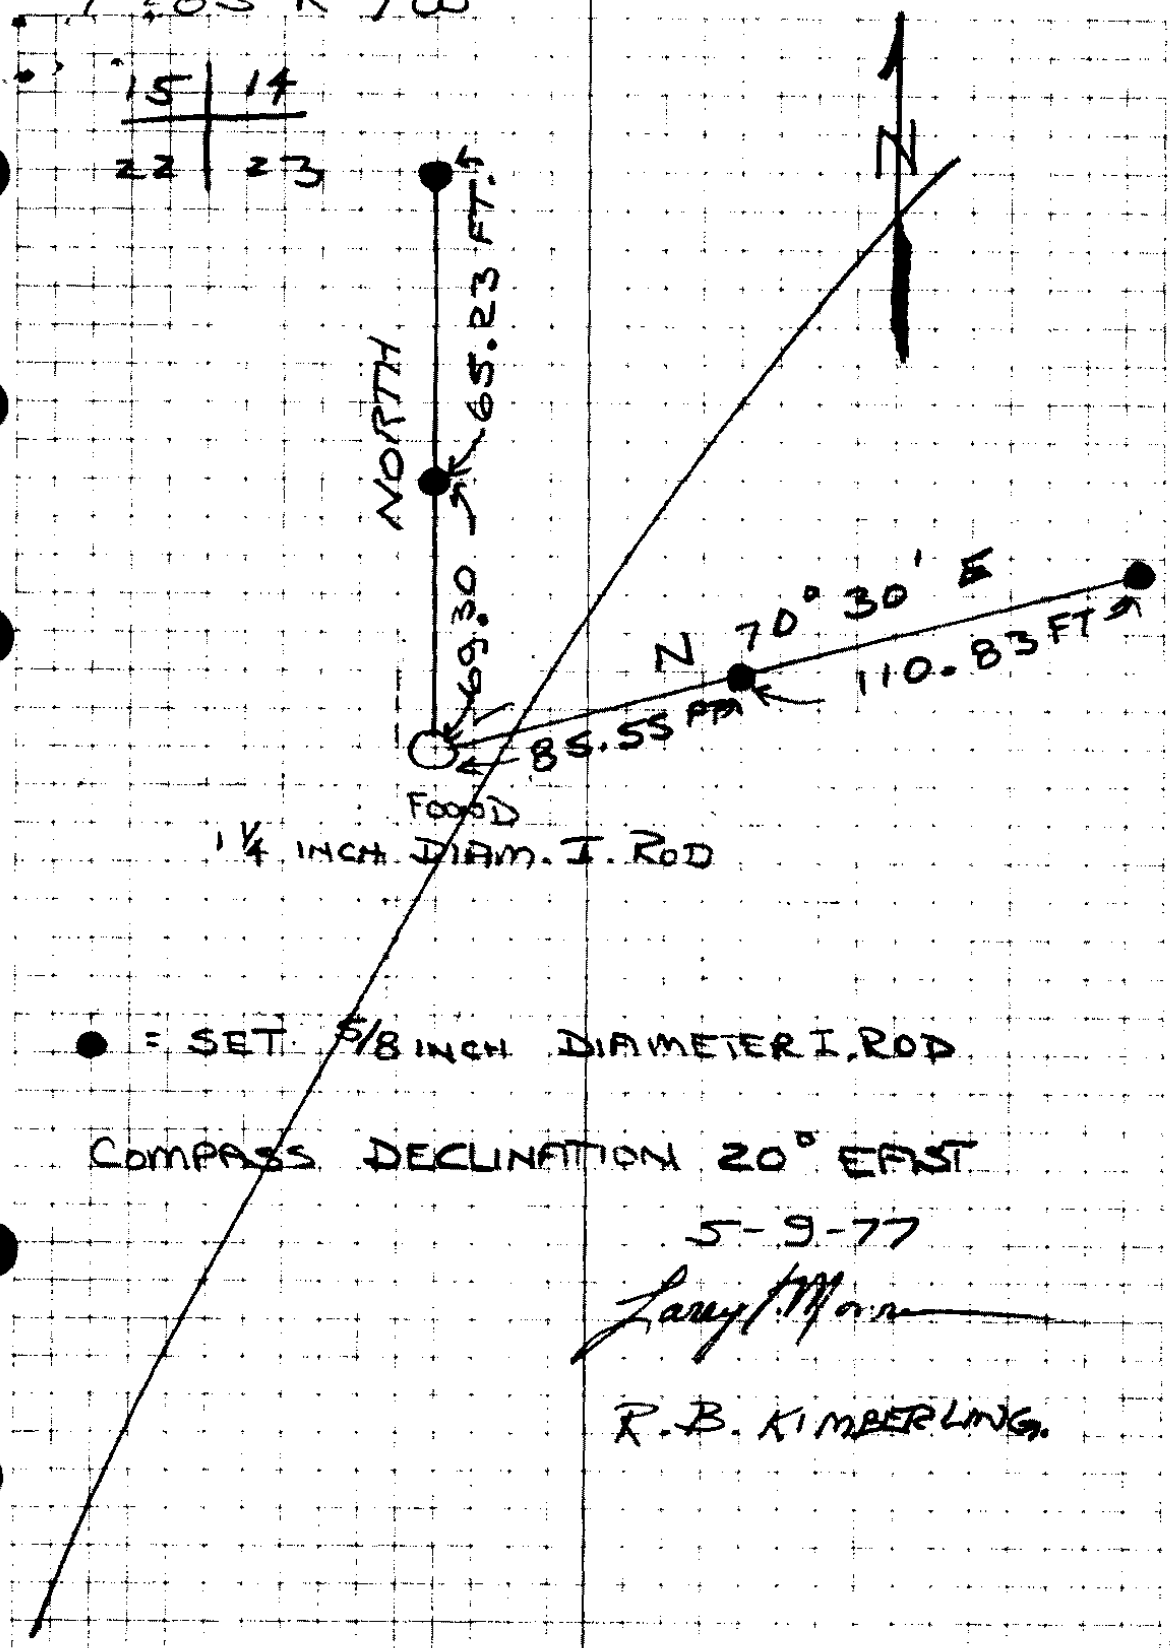

DIETZGEN NO 3855

● = SET 5/8 INCH DIAMETER I. ROD

COMPASS DECLINATION 20° EAST

5-9-77

Larry J. Moore

R. B. KIMBERLING.

CS 611/9-65

PAGE 2

C. S. File No. 59130