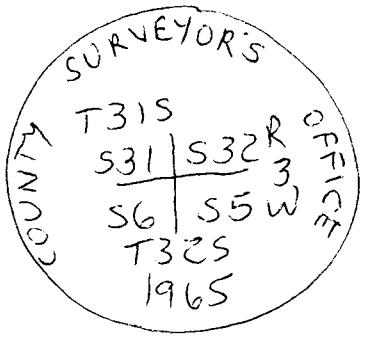

DATE: JULY 1, 1981

____Condition Report Only
____Not Found
__X__Renewed
____Unrecorded
____Surveyed In
____Referenced Out

Previous Renewal #'s 10, 42

Monument(s) Found: (Condition and Source)

1" I.P. SET BY JOHN POWELL, DOUGLAS CO. SURVEYOR'S OFFICE, IN 1965, FIRMLY SET, PROJECTING 10" ABOVE GROUND, WITH BRASS CAP MARKED AS ABOVE. AND 1 3/4" I.P. SET ALONGSIDE.

Accessories Found: (Condition and Source) ORIGINAL BT:

A 36" D. FIR, S22°E, 59 4/5 FT. TO FACE, WITH SCRIBE MARKS "BT" VISIBLE ON BARK BLAZE.

AND BTS MARKED BY POWELL IN 1965:

A 17" D. FIR, S12°E, 31 3/5 FT, WITH HEALED DOUBLE BLAZE.

#242 .. T31-3 .
#203 .. T32-3 .

U. S. File No. 61/27-8 Page 1 of 1
C

A 9" P. PINE, S35°W, 24± FT (REC. 24.6 FT.) WITH HEALED DOUBLE BLAZE.

A 13" P. PINE, N38°W, 16.7± FT. (REC. 17.0 FT.) WITH HEALED DOUBLE BLAZE.

A 22" D. FIR STUMP, N16°W, 95± FT. (REC. 94.0 FT.) WITH RENEWAL HEALED BLAZE.

Monument Set: (Procedure and Description)

New Accessories: (Description)

I MARKED NEW BT.:

A 10" P. PINE, N30°E, 16.6± FT, SCRIBED "T31SR3W S32 CS BT" ON DOUBLE BLAZE.

Location and Comments:

CORNER IS 50 FT. EAST OF BLM SNOW CREEK ACCESS ROAD.

18°E Compass Declination

U.S.F.S. Agency

LEONARD HERZSTEIN Party Chief

Notekeeper

TOM WOLFORD Witnesses

OK