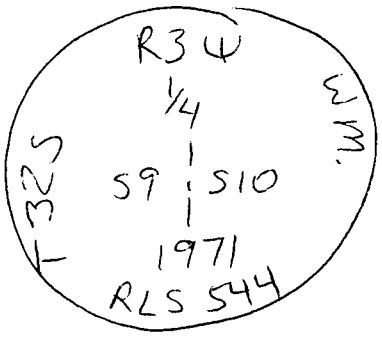

DATE: JULY 7, 1981

X Condition Report Only
___ Not Found
___ Renewed
___ Unrecorded
___ Surveyed In
___ Referenced Out

Previous Renewal #'s 155

Monument(s) Found: (Condition and Source)

2" I.P., FIRMLY SET, PROJECTING 10" ABOVE GROUND WITH BRASS CAP MARKED AS ABOVE, SET IN 1971 BY DON GARRETT.

Accessories Found: (Condition and Source)

BTs MARKED BY GARRETT IN 1971:

A 9" W. FIR, S82°E, 32.7 FT., WITH HEALED BLAZE (REC. FIR).

A 7" D. FIR, S77°45'W, 17.7 FT., WITH HEALED BLAZE (REC. FIR).

✓

U. S. File No. 61/27-10 Page ___ of ___

RENEWAL

Monument Set: (Procedure and Description)_____

New Accessories: (Description)_____

Location and Comments:

— Compass Declination
USFS Agency
LEONARD HERZSTEIN Party Chief
_____ Notekeeper
JIM LANDRUM Witnesses
OK
_____
_____