GOVERNMENT CORNER RESTORATION FORM

Township 28 S Range 6 W Sec. 35 County DOUGLAS

State OR Date 8-4-82 No.

Corner Designation

T28S R6W

1/4 S35 | S36

___ Condition Report Only
___ Not Found
✓ Renewed
___ Unrecorded
___ Surveyed In
___ Referenced Out

Previous Renewals #28 - #99

Monument(s) Found: (Condition and Source)

FD. BRASS CAP WITH 1" IP ALONGSIDE AS PER REN. #99 PROTRUDING 14" OUT OF GROUND.

MONUMENT DETAIL

SURVEYORS COUNTY OFFICE

T28S R6W

1/4 S35 | S36

1961

Accessories Found:

SEARCH FOR BT'S REVEALED NO EVIDENCE LEFT FROM EITHER RENEWAL.

#159 X

G.L. File No. 62/1-4 C

RENEWAL

Monument Set (Procedure and Description)

Monument Detail

New Accessories

8" W. OAK SCRIBED " 1/4 S 36 CS BT" IN DOUBLE BLAZE BEARS N 50 1/2° E 82 4.
8" W. OAK SCRIBED " 1/4 S 36 CS BT" IN DOUBLE BLAZE BEARS N 69° E 75 0.
18" B. OAK SCRIBED " 1/4 S 36 CS BT" IN DOUBLE BLAZE BEARS S 2° E 36 8.
SE COR. NEW METAL BARN BEARS N 73 1/2 W 67 5.
FENCE COR. WITH FENCES RUNNING NORTH, SOUTH & WEST BEARS S 57° E 12 1 7

Sketch of Monument, Acessories, and General Area

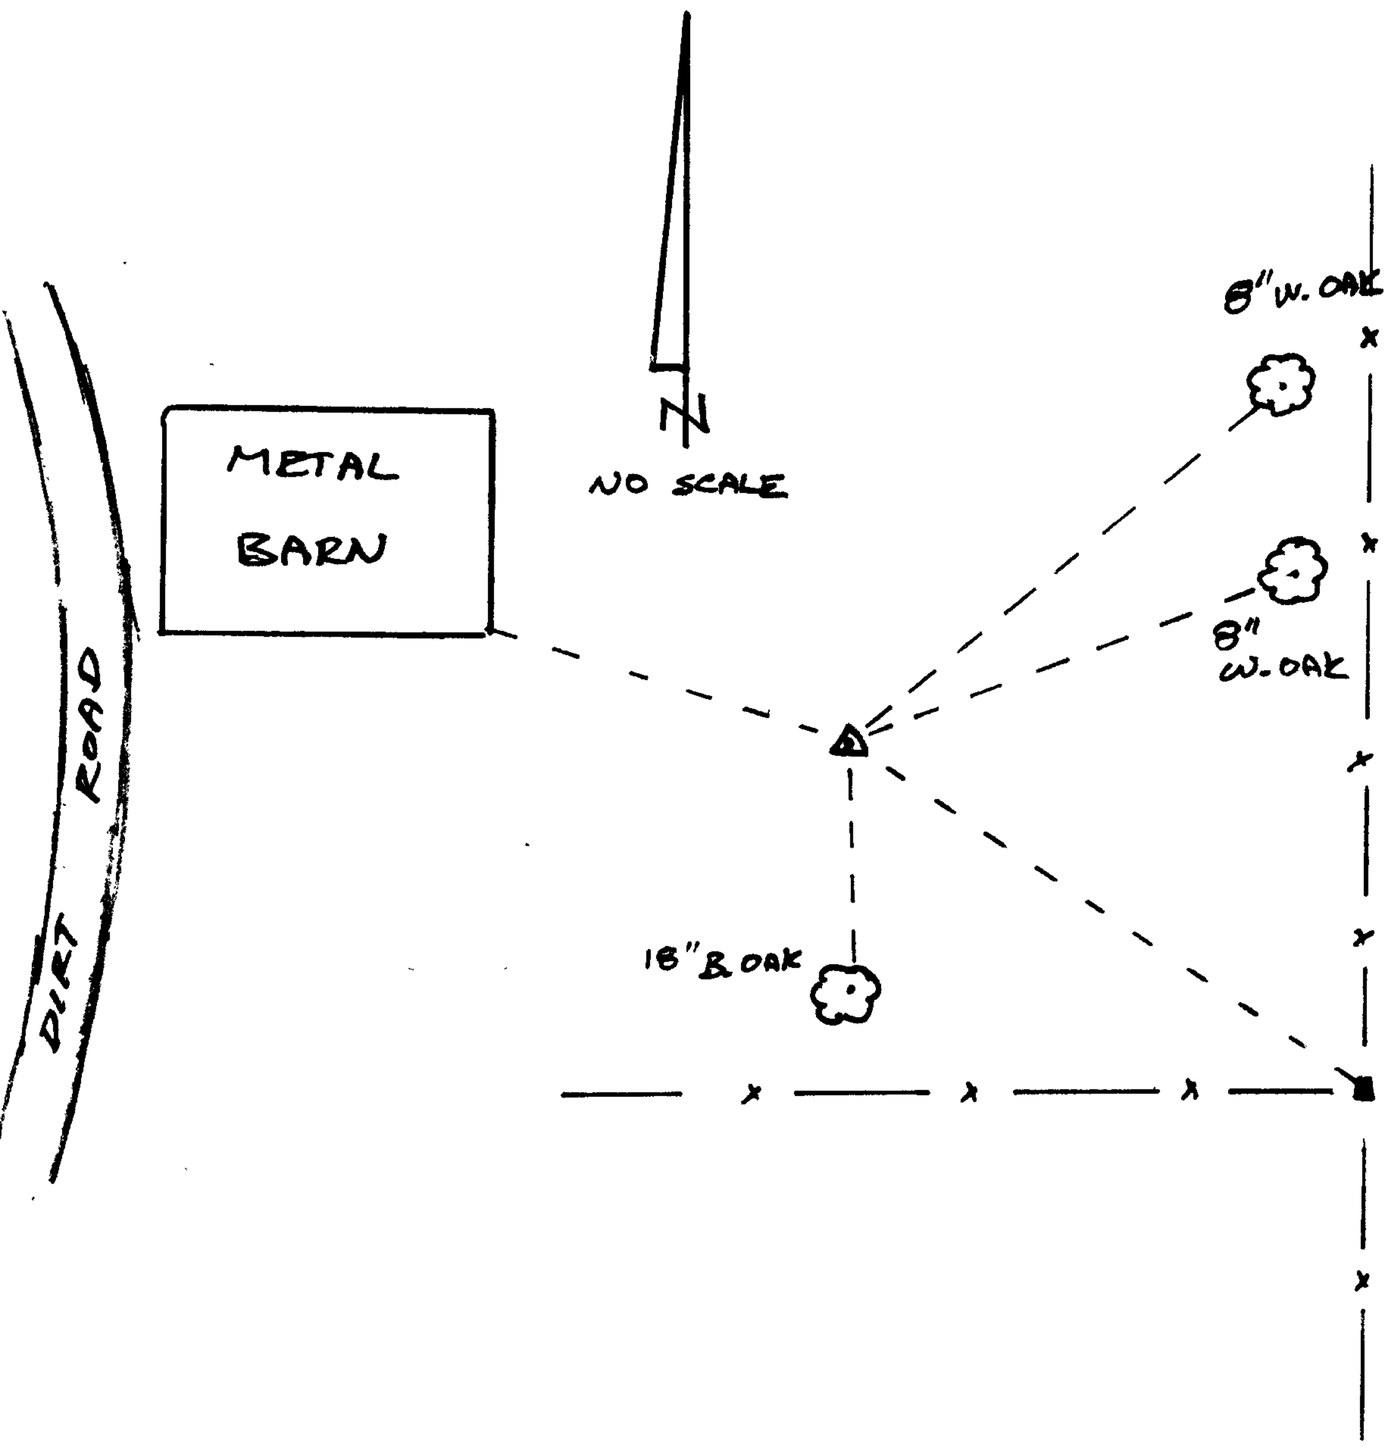

Location & Comments

Comp. Declin. 19° E
Agency DCSO
Party Chief GREGORY E QUIBELL
Notekeeper Gregory E. Quibell
Witnesses JOHN POWELL

Surveyor's Seal

REGISTERED PROFESSIONAL LAND SURVEYOR
Gregory E. Quibell
OREGON
JULY 13, 1979
GREGORY E. QUIBELL
1834