GOVERNMENT CORNER RESTORATION FORM

Township 29S Range 7W Sec. 4 County DOUGLAS

State OREGON Date 8-24-82 No.

Corner Designation

T28S
S 33
1/4 × R 7 W
S 4
T29S

___ Condition Report Only
___ Not Found
X Renewed
___ Unrecorded
___ Surveyed In
___ Referenced Out

Previous Renewals NONE, M12-72 RM2-46

MONUMENT DETAIL

Monument(s) Found: (Condition and Source)

NO ORIGINAL POST FD.

FD. (ORIGIN UNKNOWN) A 6"x12" QUARTZ ROCK NOW 13"x8"x6" QUARTZ ROCK AS USED IN 1957 SURVEY BY A. BOYER AND 1973 SURVEY BY G. BAUGHMAN, M12-72 AND RM2-46 RESPECTIVELY, DOUGLAS SURVEY RECORDS. NO MARKS ON STONE.

Accessories Found:

A 40" DIAM. B. OAK WITH PREVIOUSLY CUT OUT BLAZE, ROTTED CENTER BEARS S. 25°E. 106.3 FT. DIST. (REC. BRG AND DIST) THIS TREE WAS REFERRED TO AS THE ORIG. 6 IN. B. OAK IN THE ABOVE MENTIONED SURVEYS. NO VISIBLE SCRIBE FD.

#245 T28-7 X

#274 T29-7 X

C.E. File No. 62/1-14 C

RENEWAL

Monument Set (Procedure and Description)

SET A 1"x30" IRON PIPE WITH BRASS CAP STAMPED "DOUGLAS COUNTY SURVEYOR" T28S 1/4 S33 S4 R7W T29S 1982 AT RECORD BRG AND DIST FROM 40" OAK. WHICH IS THE POSITION OF FD. STONE PROTRUDING 10 IN. ABOVE THE GROUND WITH QUARTZ ROCK ALONG SOUTH SIDE OF CAP.

SET THIS COR. TO PERPETUATE A USED COR. POSITION

Monument Detail

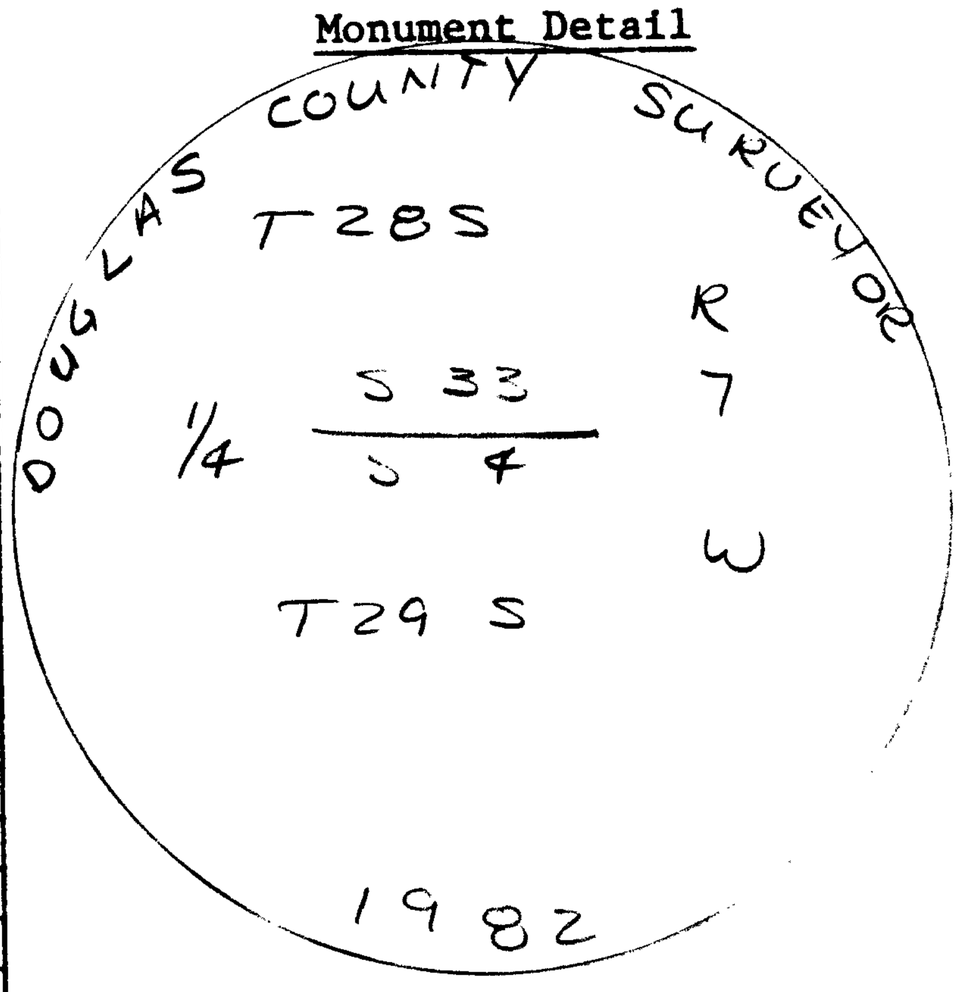

New Accessories

A 13 IN. DIAM. B. OAK SCRIBED "1/4 S4 C.S BT" IN A DOUBLE BLAZE BEARS S. 11 3/4° W., 128.1 FT. DIST.
A 5/8"x30" IRON ROD WITH ALUMINUM CAP STAMPED "BOL" BEARS N. 43° W., 32.95 FT. DIST. SET FLUSH WITH GROUND.
A 5/8"x30" IRON ROD WITH ALUMINUM CAP STAMPED "BOZ" BEARS N. 62° E., 35.60 FT. DIST. SET FLUSH WITH GROUND.
NO OTHER TREES WITHIN REASONABLE RANGE

Sketch of Monument, Acessories, and General Area

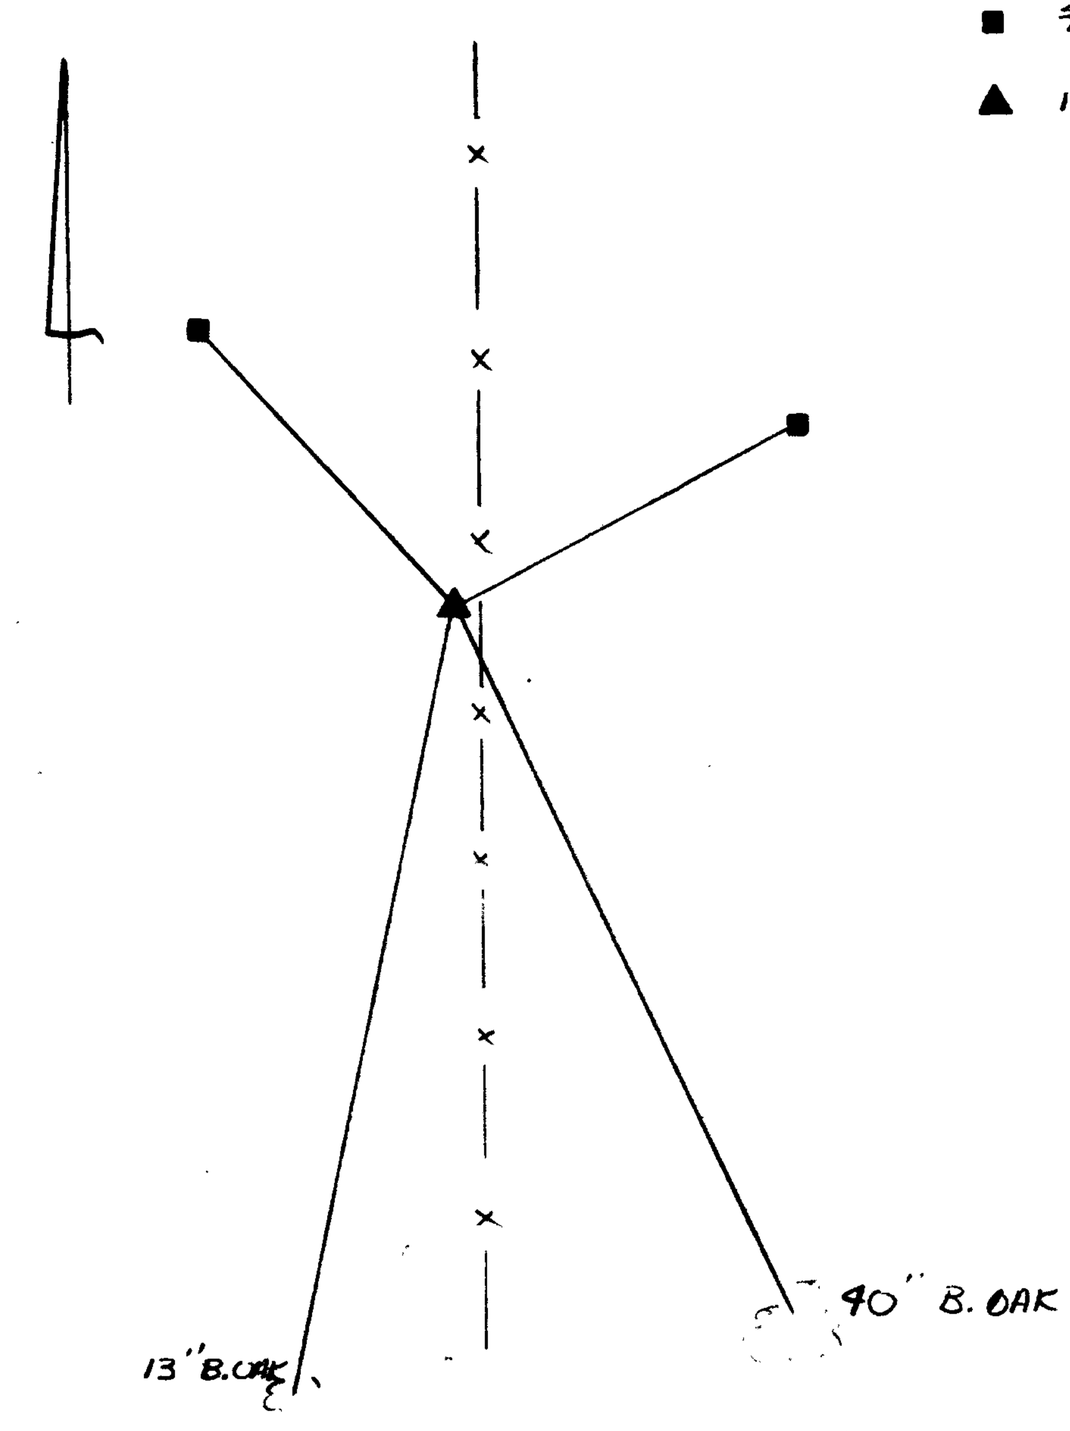

Location & Comments

COR. FALLS ON A WEST SLOPE 29 FT. WEST OF A N-S FENCE

Comp. Declin. 20° EAST
Agency DCSO
Party Chief KAREN REED
Notekeeper Karen Reed
Witnesses TERRIE R. PLOUFF

Surveyor's Seal

REGISTERED PROFESSIONAL LAND SURVEYOR

OREGON
JULY 13, 1979
LARRY E. MONREAN
#1830