GOVERNMENT CORNER RESTORATION FORM

Township 32 S Range 4 W Sec. 17 County DOUGLAS

State OR Date 12-20-82 No.

Corner Designation

T32S R4W

1/4 17/20

___ Condition Report Only
___ Not Found
✓ Renewed
___ Unrecorded
___ Surveyed In
___ Referenced Out

Previous Renewals #16 1971 RESURVEY

Monument(s) Found: (Condition and Source)

FD. 2½" IP WITH BRASS CAP ATTACHED, FIRMLY SET 0.4 FT NORTH OF FENCE COR.

BRASS CAP PER 1971 BLM RESURVEY.

MONUMENT DETAIL

T32S R4W

1/4 S17/S20

1971

Accessories Found:

* FD. ORIG. 8" NOW 28" MADRONE, BARK GONE BLAZE NOT VISIBLE, BEARS N 78°W 13.8 FT. TREE IS DEAD AND SOON TO BE CUT DOWN. I MOVE BT TAGS TO BASE OF TREE.
* FD. 10" NOW 19" FIR PER REN. #16, WITH GOOD DOUBLE BLAZE BEARS S 46°W 47.8 FT.
* FD. 8" NOW 13" FIR PER RESURVEY WITH GOOD SINGLE BLAZE, BEARS N 28 3/4 E 47.5 FT.

#145 ✓

C. S. File No. 62/1-37

RENEWAL

Monument Set (Procedure and Description)

Monument Detail

New Accessories

11" CEDAR SCRIBED "Y4S17CS BT" IN DOUBLE BLAZE BEARS N76E 6.4 FT.

Sketch of Monument, Acessories, and General Area

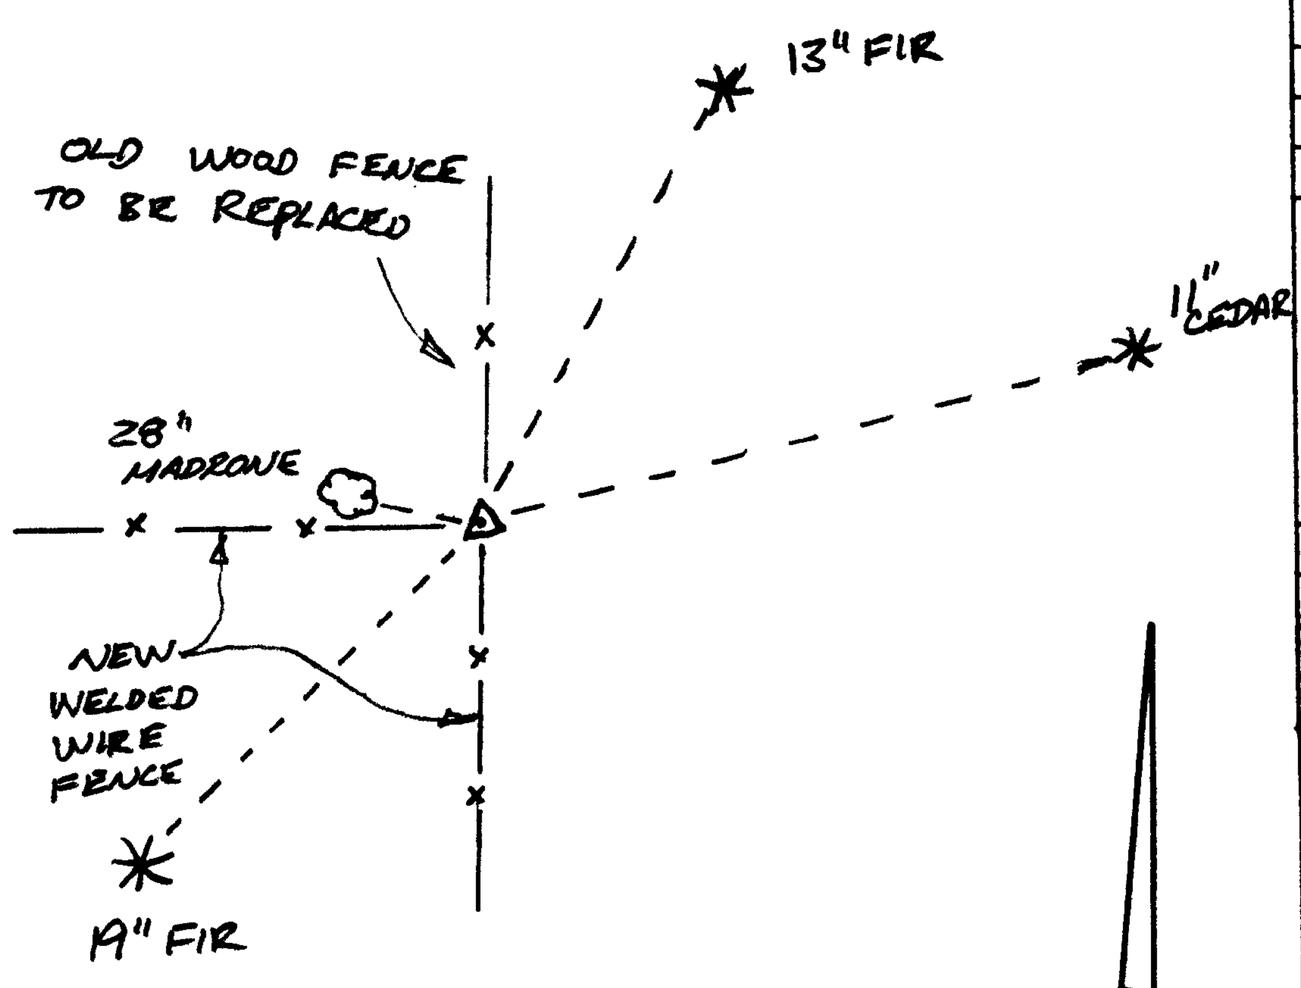

Location & Comments

DCSO BT TAGS ON ALL TREES

Comp. Declin. 19°E
Agency DCSO
Party Chief GREGORY E. QUIBELL
Notekeeper Gregory E. Quibell
Witnesses JOHN POWELL
RANDY SMITH

OK

Surveyor's Seal

REGISTERED PROFESSIONAL LAND SURVEYOR

Gregory E. Quibell

OREGON
JULY 13, 1979
GREGORY E. QUIBELL
1834