GOVERNMENT CORNER RESTORATION FORM

Township 31S Range 7W Sec. 17 County DOUGLAS

State OR Date 2-3-83 No.

Corner Designation

1/4 T 31S R 7W

17/20

___ Condition Report Only
___ Not Found
✓ Renewed
___ Unrecorded
___ Surveyed In
___ Referenced Out

Previous Renewals #91

Monument(s) Found: (Condition and Source)

FD. ORIG. 7" NOW 7" LIVE OAK COR. TREE WITH GOOD SCAR ON NORTH SIDE. BRASS CAP SET IN 1970 BY DCSO NO LONGER IN GROUND.

MONUMENT DETAIL

Accessories Found:

FD. ORIG. 14" FIR, NOW 14", WITH PARTIALLY HEALED PITCHED OVER BLAZE PER REN. #91, BEARS S 32 W 42 FT.

FD ORIG. 7" LIVE OAK, NOW 7" WITH PREVIOUSLY OPENED NOW ROTTED FACE WITH NO SCRIBING VISIBLE, BEARS N 42 E 10 FT.

FD. 18" FIR PER REN. #91, NOW 19" WITH PARTIALLY HEALED PITCHED OVER BLAZE, BEARS N 68 E 26 FT.

#110 X

C.S. File No. 62/7-14C

RENEWAL

Monument Set (Procedure and Description)

Monument Detail

New Accessories

7" FIR SCRIBED "¼ S17 CS BT" IN DOUBLE BLAZE BEARS N85°W 23± FT.

8" LIVE OAK SCRIBED "¼ S 20 CS BT" IN DOUBLE BLAZE BEARS S64E 20± FT.

5/8" x 30" IR WITH ALUM. CAP MARKED "DOUGLAS CO. SURVEYOR BO 1", BEARS N43°W 10± FT.

5/8" x 30" IR WITH ALUM. CAP MARKED "DOUGLAS CO. SURVEYOR BO 2", BEARS S55W 12± FT

Sketch of Monument, Acessories, and General Area

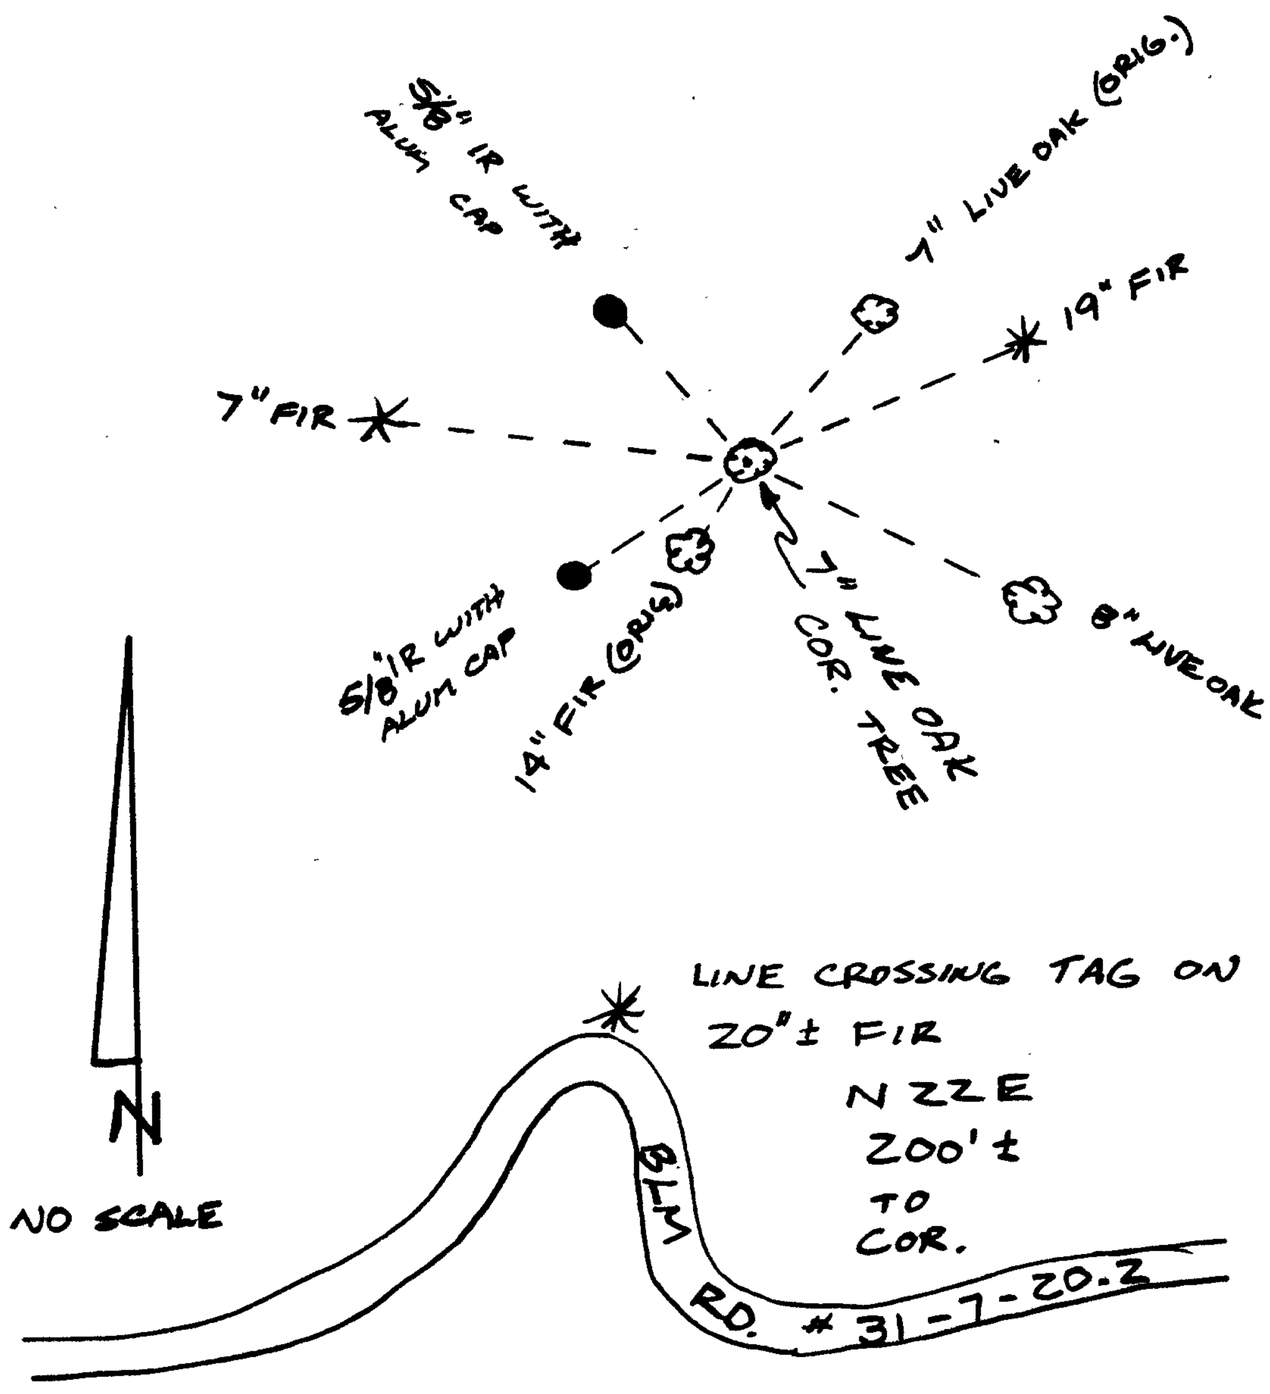

Location & Comments

Comp. Declin. 19°E
Agency DCSO
Party Chief GREGORY E. QUIBELL
Notekeeper Gregory E. Quibell
Witnesses JOHN POWELL
RANDY SMITH

Surveyor's Seal

REGISTERED PROFESSIONAL LAND SURVEYOR

Gregory E. Quibell

OREGON
JULY 13, 1979
GREGORY E. QUIBELL
1834