GOVERNMENT CORNER RESTORATION FORM

Township 25S Range 1E 2E Sec. 25 & 36 30 & 31 County DOUGLAS

State OREGON Date MAY 12, 1983 No.

Corner Designation

SECTION CORNER TO SECTIONS 25 & 36, T25S-R1E & SECTIONS 30 & 31, T25S-R2E.

___ Condition Report Only
___ Not Found
X Renewed
___ Unrecorded
___ Surveyed In
___ Referenced Out

Previous Renewals

MONUMENT DETAIL

Monument(s) Found: (Condition and Source)

2" IRON POST, FIRMLY SET, PROJECTING 6" ABOVE THE GROUND WITH BRASS CAP MARKED AS SHOWN, SET BY G.L.O. IN 1927.

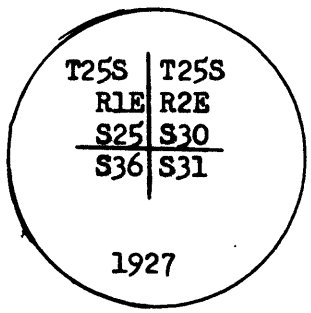

Accessories Found:

A 20" D. FIR, N32°E, 40.9 FT. WITH HEALED BLAZE.
A 21" R. CEDAR, S42°E, 29.6 FT.(REC. 30.4 FT.) WITH HEALED BLAZE.
A 17" W. FIR, S56°W, 21.5 FT.(REC. 22.4 FT.) WITH HEALED BLAZE.
A ROOTHOLE, N86°W, 21.1 FT. WITH DECAYED LOG, SIZE INDETERMINATE, ALONGSIDE WITH FRAGMENTARY SCRIBE MARKS VISIBLE ON DECAYED BLAZE.

#46 T25-1E X
#8 T25-2E ✓

G.L.O. File No. 62/10-3C

RENEWAL

Monument Set (Procedure and Description)

NONE

Monument Detail

New Accessories

I MARKED A NEW BT:

S25 LEA 7-20-83

A 20" D. FIR, N3½~~W~~, 23.1 FT. SCRIBED "T25S R1E ~~S30~~ CS BT" ON A SINGLE BLAZE.

Sketch of Monument, Acessories, and General Area

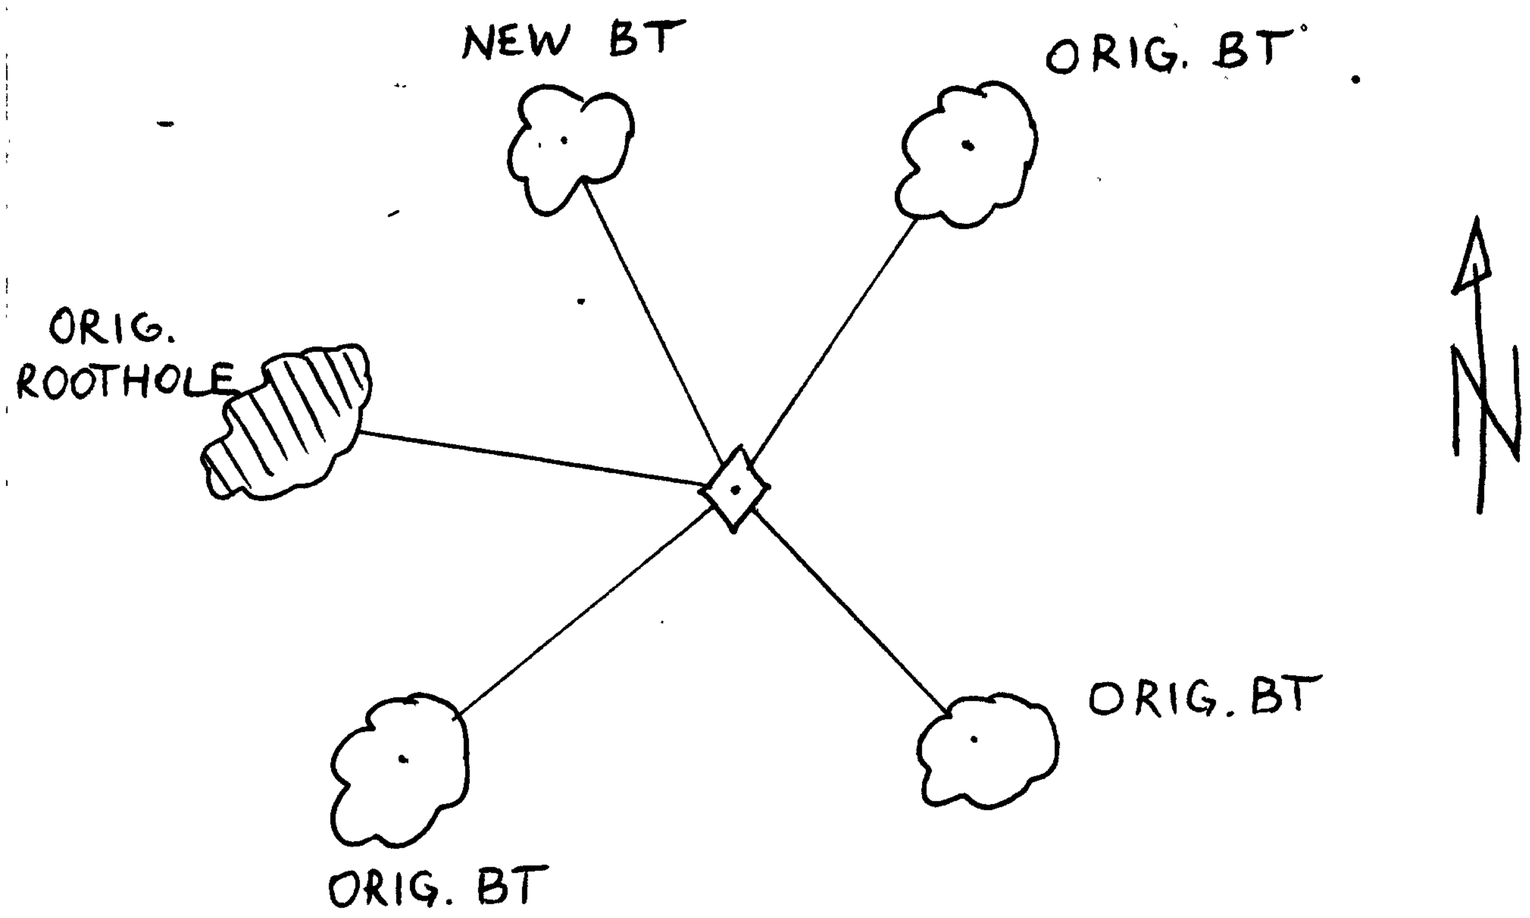

Location & Comments

CORNER IS LOCATED ON A STEEP NW SLOPE, APPROXIMATELY 300 FT. ~~SOUTH~~ EAST OF THE END OF U.S.F.S. ROAD #4760-400.

Comp. Declin. 19° E
Agency DOUGLAS CO. SURVEYOR'S OFFICE
Party Chief JIM LANDRUM, DEPUTY SURV.
Notekeeper LEONARD HERZSTEIN
Witnesses LEONARD HERZSTEIN

Surveyor's Seal

REGISTERED
PROFESSIONAL
LAND SURVEYOR

OREGON
FEBRUARY 4, 1983
JAMES N. LANDRUM
2024