R

FILED
RECEIVED

GOVERNMENT CORNER RESTORATION FORM

MAY 18 1984

COUNTY SURVEYOR
DOUGLAS COUNTY, ORE.

Township 27 S. Range 6 W. Sec. 26 County DOUGLAS

State OREGON Date 5-14-84 No.

Corner Designation

1/4 S 27 | S 26

___ Condition Report Only
___ Not Found
X Renewed
___ Unrecorded
___ Surveyed In
___ Referenced Out

Previous Renewals # 87 BY J.W. BYRON 1961

MONUMENT DETAIL

Monument(s) Found: (Condition and Source)

FD BYRON'S MONUMENT AN IRON PIPE WITH BRASS CAP FIRMLY SET IN NORTH SOUTH FENCE LINE.

ORIGINAL POST MONUMENT NOT FOUND.

COUNTY SURVEYOR'S OFFICE
T 27 S R 6 W
1/4 S 27 | S 26
1961

Accessories Found:

ORIGINAL BT'S

1. A 7" DIA. Y OAK NOW A 20" DIA B. OAK WITH PREVIOUSLY ~~HEALED~~ OPENED & PARTIALLY HEALED BLAZE WITH NO SCRIBING VISIBLE BEARS N 38¾° W 20⅘ FT (REC. 20 5 FT).

2. A 14" DIA. Y OAK NOW A 24" DIA. B. OAK WITH FAINT SCAR BEARS N 24° E 32⅔ FEET (REC. N 29° E 31⅘ FT).

BT'S FROM RENEWAL # 87

3. A W. OAK 11 NOW 13 INCHES DIAM. WITH WELL HEALED DOUBLE BLAZE BEARS S 81° E 25.8 FEET.

4. A B. OAK 11 NOW 14 INCHES DIAM WITH WELL HEALED DOUBLE BLAZE BEARS N 87° W 30⅘ FEET. THIS IS A DOUBLE TRUNK TREE.

Ren # 171

C.S. File No. 62/18-3

C

# RENEWAL

## Monument Set (Procedure and Description)

NONE

## Monument Detail

## New Accessories

NONE

## Sketch of Monument, Acessories, and General Area

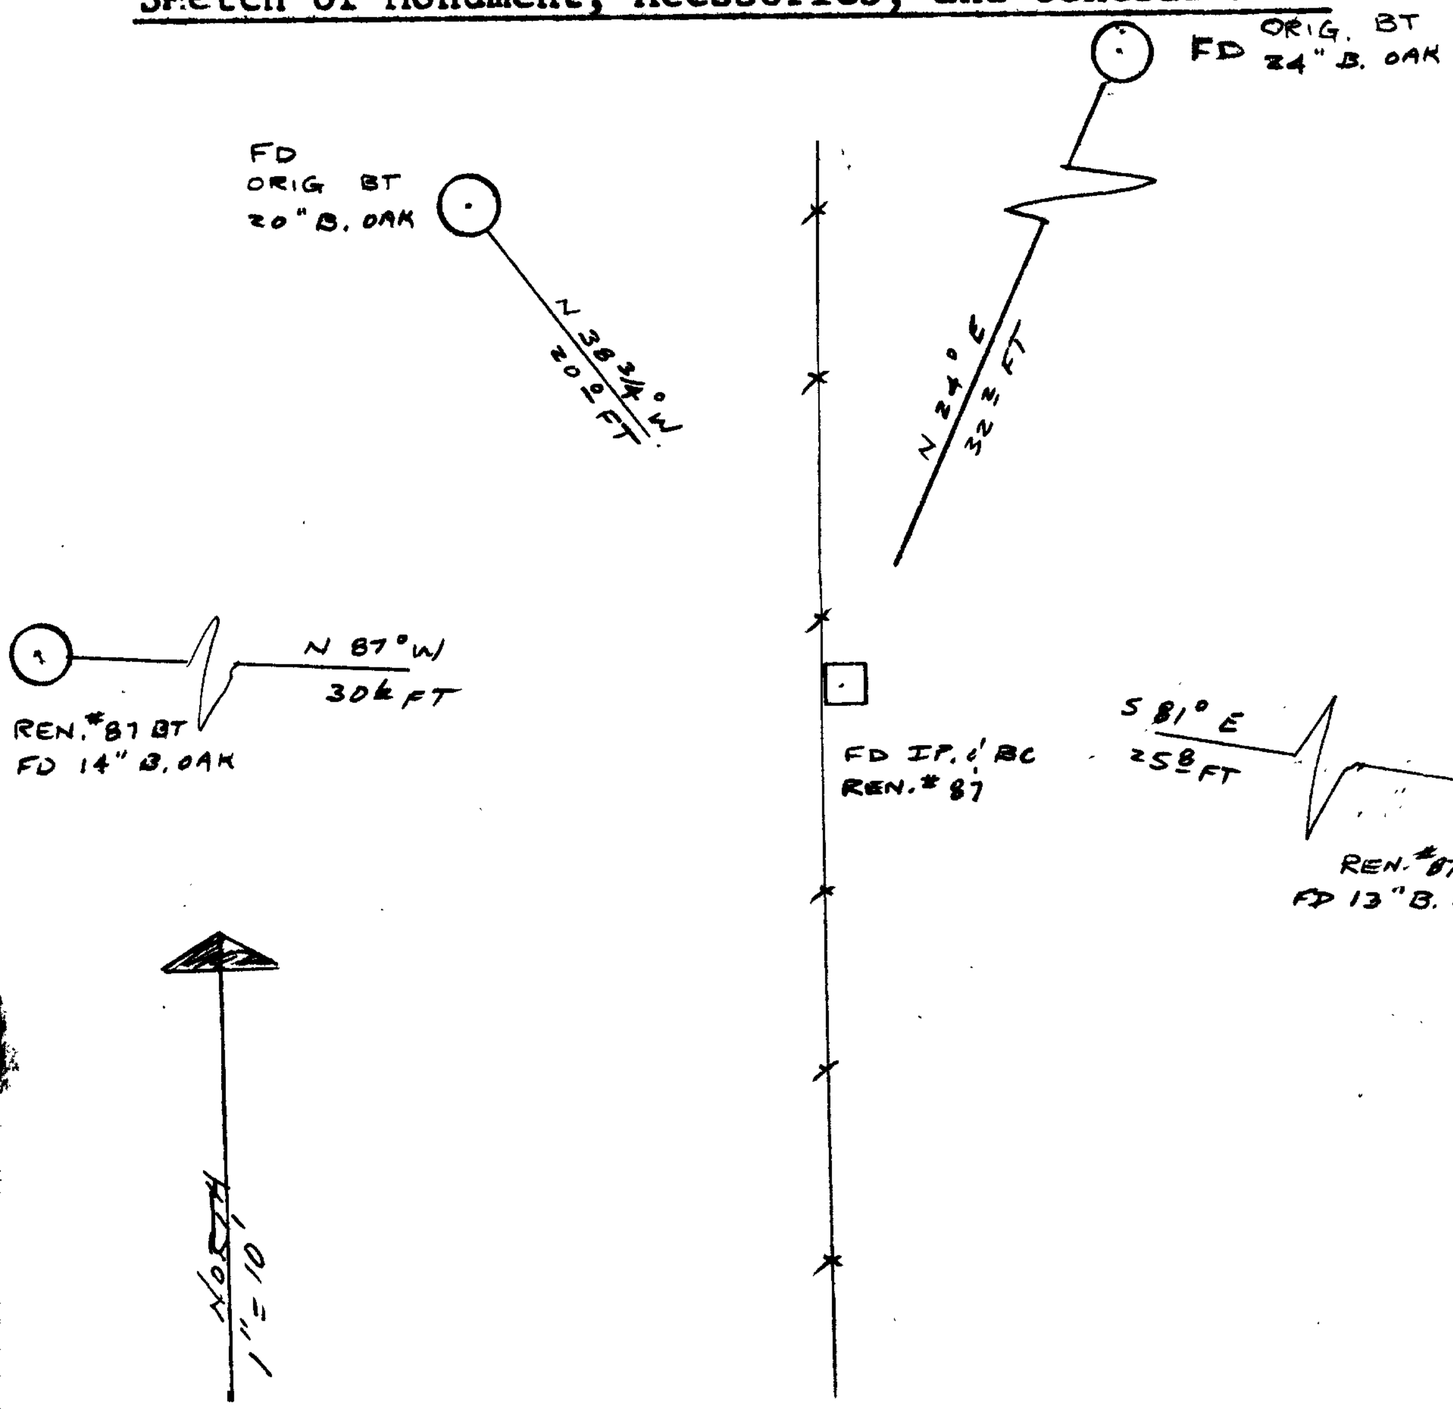


## Location & Comments

Comp. Declin. 19° EAST
Agency DOUG. COUNTY SURVEYOR'S OFFICE
Party Chief LARRY E. MONREAN
Notekeeper " " "
Witnesses J.R. LUNDEEN
S.J. FLAUSE

Surveyor's Seal

REGISTERED
PROFESSIONAL
LAND SURVEYOR

Larry E. Monrean

OREGON
JULY 13, 1979
LARRY E. MONREAN
#1830