GOVERNMENT CORNER RESTORATION FORM

Township 26S Range 2W Sec. 13 County DOUGLAS

State OREGON Date 12/19/1984 No.

Corner Designation

S14	S13
S23	S24

___ Condition Report Only
___ Not Found
X Renewed
___ Unrecorded
___ Surveyed In
___ Referenced Out

Previous Renewals #27, 1975 BLM RESURVEY

Monument(s) Found: (Condition and Source)

A DCSO DISK ON A I.P. PROTRUDES 6 IN. ABOVE A 2 FT DIA. MOUND OF STONE. MARKED AS NOTED. (PER. REN #27).

MONUMENT DETAIL

COUNTY SURVEYORS OFFICE

T26S R2W

S14	S13
S23	S24

1961

Accessories Found:

20" NOW A 38" DIA. D. FIR WITH A DOUBLE WELL HEALED BLAZE BEARS S20°E, 21.1 FT (REC. 19.1' IS TO FACE OF BLAZE) (ORIG)

24" NOW A 30" DIA, 1 FT HIGH DECAYED FIR STUMP NO SCRIBING OR BLAZES FOUND BEARS N26°E, 44.9 FT (ORIG.)

NO OTHER ORIG. BT'S FOUND

15" NOW A 20" DIA. D. FIR WITH A WELL HEALED DOUBLE BLAZE BEARS S81°W, 33.7 FT (REC. S83°W 34.3' PER REN #27, DIST. IS A SLOPE MEASUREMENT TO FACE OF BLAZE) (REC. DIST 35.0' PER 1975 BLM RESURVEY). BT PER. REN. #27.

6" NOW A 7" DIA. W. OAK WITH A WELL HEALED DOUBLE BLAZE BEARS N 86½°W, 23.4 FT (REC. N84½°W, 24.1' PER REN #27, DIST IS A SLOPE MEASUREMENT TO FACE OF BLAZE) (REC. DIST 24.4 PER 1975 BLM RESURVEY). BT PER. REN #27.

7" NOW A 10" DIA. W. OAK WITH A WELL HEALED DOUBLE BLAZE BEARS S70°E, 22.0 FT BT PER REN #27.

5" NOW A 7" DIA. CEDAR WITH A PARTIALY HEALED DOUBLE BLAZE SCRIBED "X BT" BEARS N66°E, 32.7 FT BT PER 1975 BLM RESURVEY

#134 +

C.S. File No. 62/21-11C

RENEWAL

Monument Set (Procedure and Description)

NONE

Monument Detail

N/A

New Accessories

NONE

Sketch of Monument, Acessories, and General Area

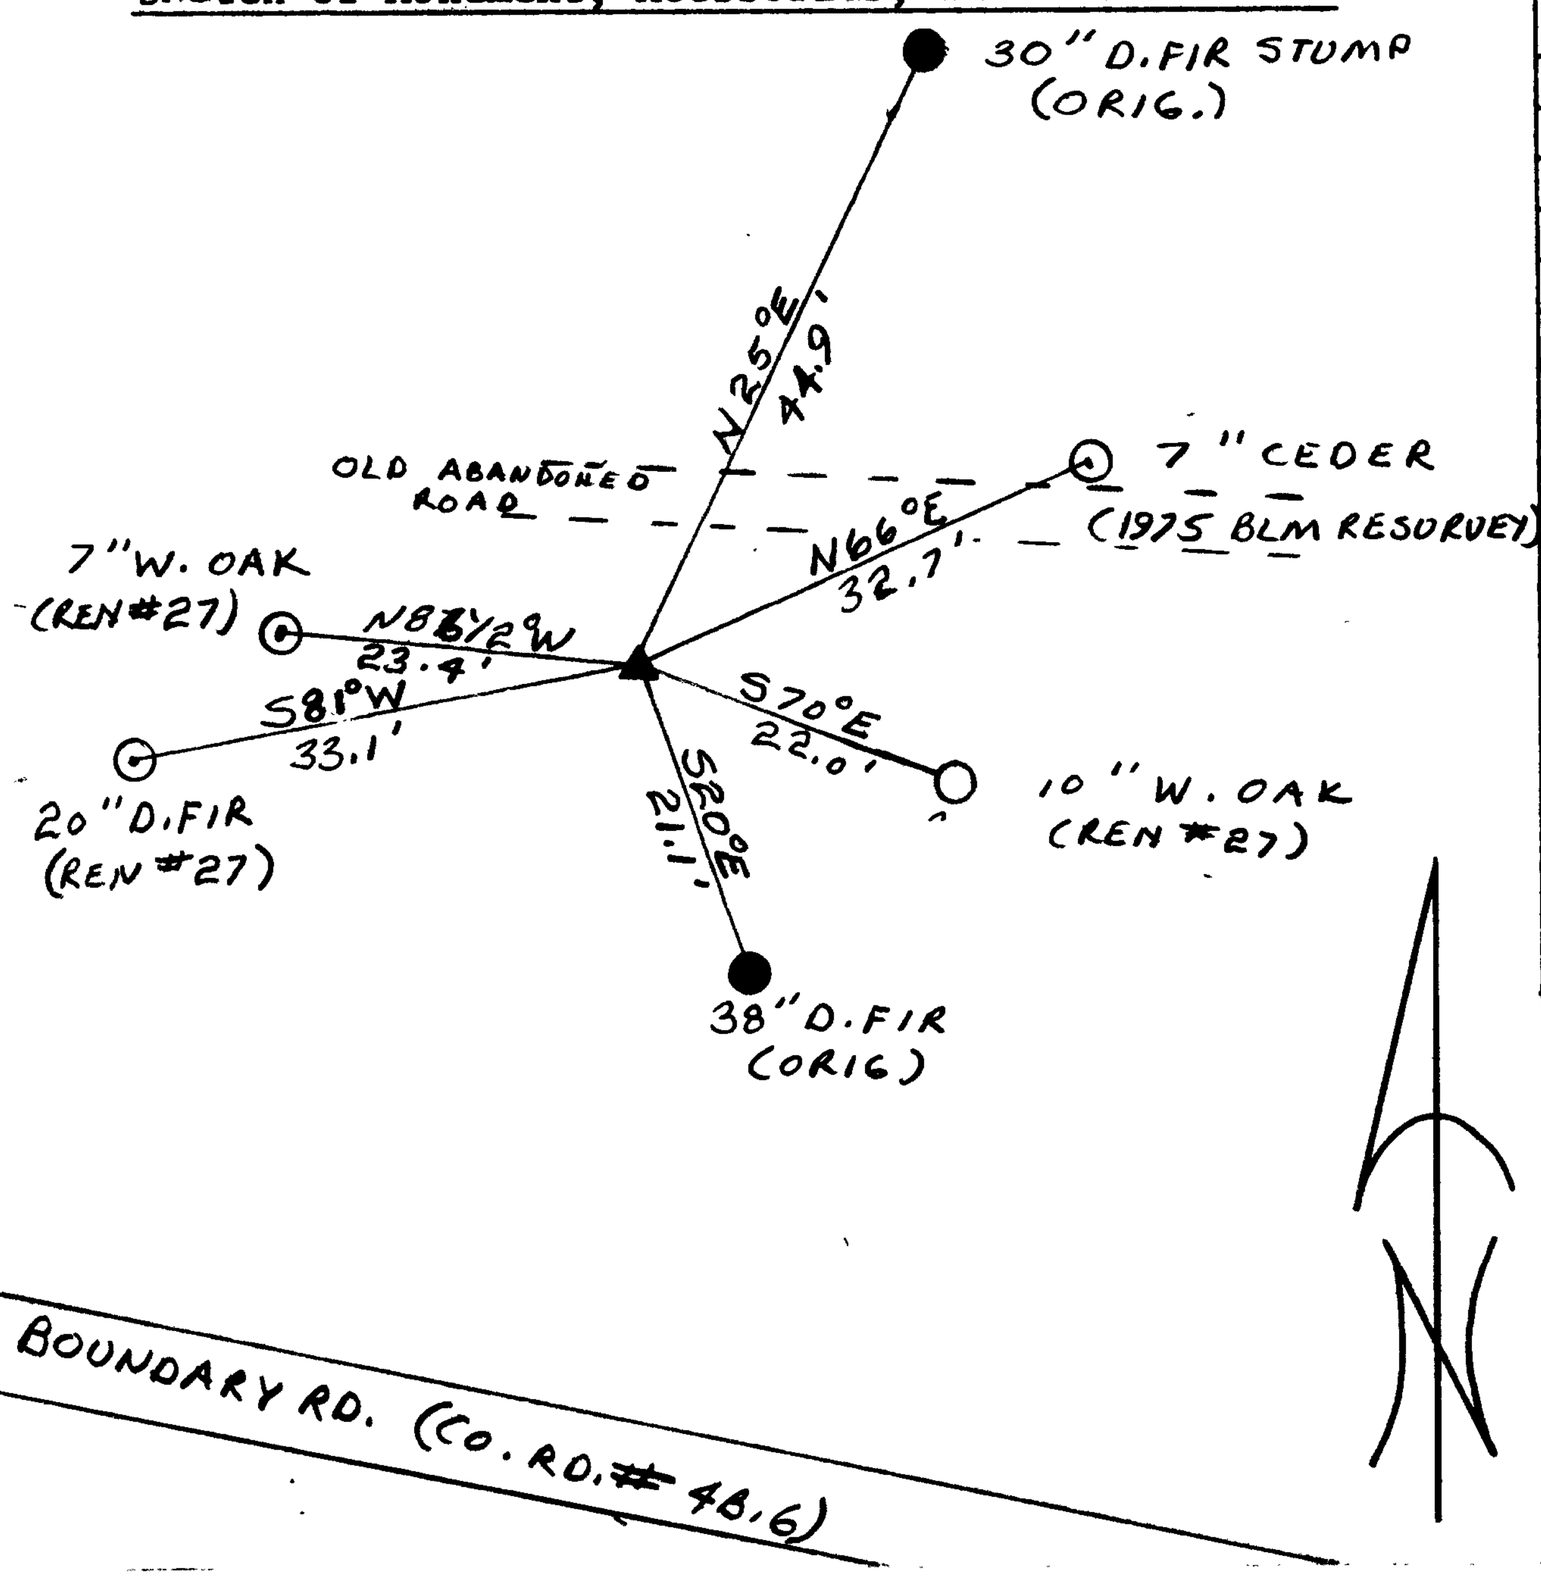

Location & Comments

CORNER LIES APPROX. 100 FT NORTH OF BOUNDARY RD.

Comp. Declin. 18½°E
Agency DCSO
Party Chief RANDALL W. SMITH
Notekeeper Randall W. Smith
Witnesses STEPHEN J. FLAUSE

Surveyor's Seal

REGISTERED PROFESSIONAL LAND SURVEYOR

Larry E. Monrean

OREGON
JULY 13, 1979
LARRY E. MONREAN
#1830