GOVERNMENT CORNER RESTORATION FORM

RECEIVED 8/21/85

Township 32S Range 1W Sec. 19 County DOUGLAS

State OREGON Date JULY 15, 1985 No. L.S. 1181

Corner Designation

1/4 CORNER OF SECTIONS 19, T32S, R1W, AND SECTION 24, T32S, R2W.

____ Condition Report Only
____ Not Found
____ Renewed
X Unrecorded
____ Surveyed In
____ Referenced Out

Previous Renewals T32S R1W - #~~68~~ #60, M56-69
T32S R2W - #83

Monument(s) Found: (Condition and Source)

2 1/2" DIAMETER IRON PIPE, FIRMLY SET, ~~PROJECTING~~ FLUSH WITH A 2 FT. DIAMETER MOUND OF STONE WITH A 3" DIAMETER BRASS CAP MARKED AS SHOWN, SET BY GLEN BAUGHMAN, L.S. 536, IN 1976.

A STEEL FENCE POST BEARS EAST, 39 FT. WITH FOREST SERVICE SIGNS # 54-2 & 54-9 ATTACHED, AS A GUARD POST.

MONUMENT DETAIL

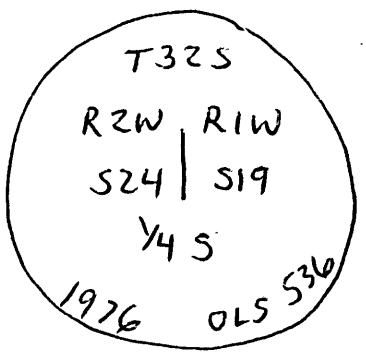

Accessories Found:

B.T.S BY BAUGHMAN IN 1976:
- A 7" CEDAR, S82°E, 31 FT. WITH SCRIBE MARKS "T32S R1W 1/4 S19" VISIBLE ON PARTIALLY HEALED DOUBLE BLAZE WITH A 3/4" BRASS WASHER, STAMPED "LS 536", NAILED FLUSH TO LOWER BLAZE.
- A 10" DOUG. FIR, N29°W, 18 FT. WITH HEALED DOUBLE BLAZE.

AND AN UNRECORDED B.T. BY BAUGHMAN IN 1976:
- A 12" DOUG. FIR, S51°E, 20 FT. WITH SCRIBE MARKS "T32S R1W S19 BT" VISIBLE ON PARTIALLY HEALED DOUBLE BLAZE WITH A 3/4" BRASS WASHER, STAMPED "LS 536", NAILED FLUSH TO LOWER BLAZE.

#100 T.32-1 X
#124 T.32-2 X

C.S. File No. 62/26-6

RENEWAL

Monument Set (Procedure and Description)

NONE

Monument Detail

New Accessories

NONE

Sketch of Monument, Acessories, and General Area

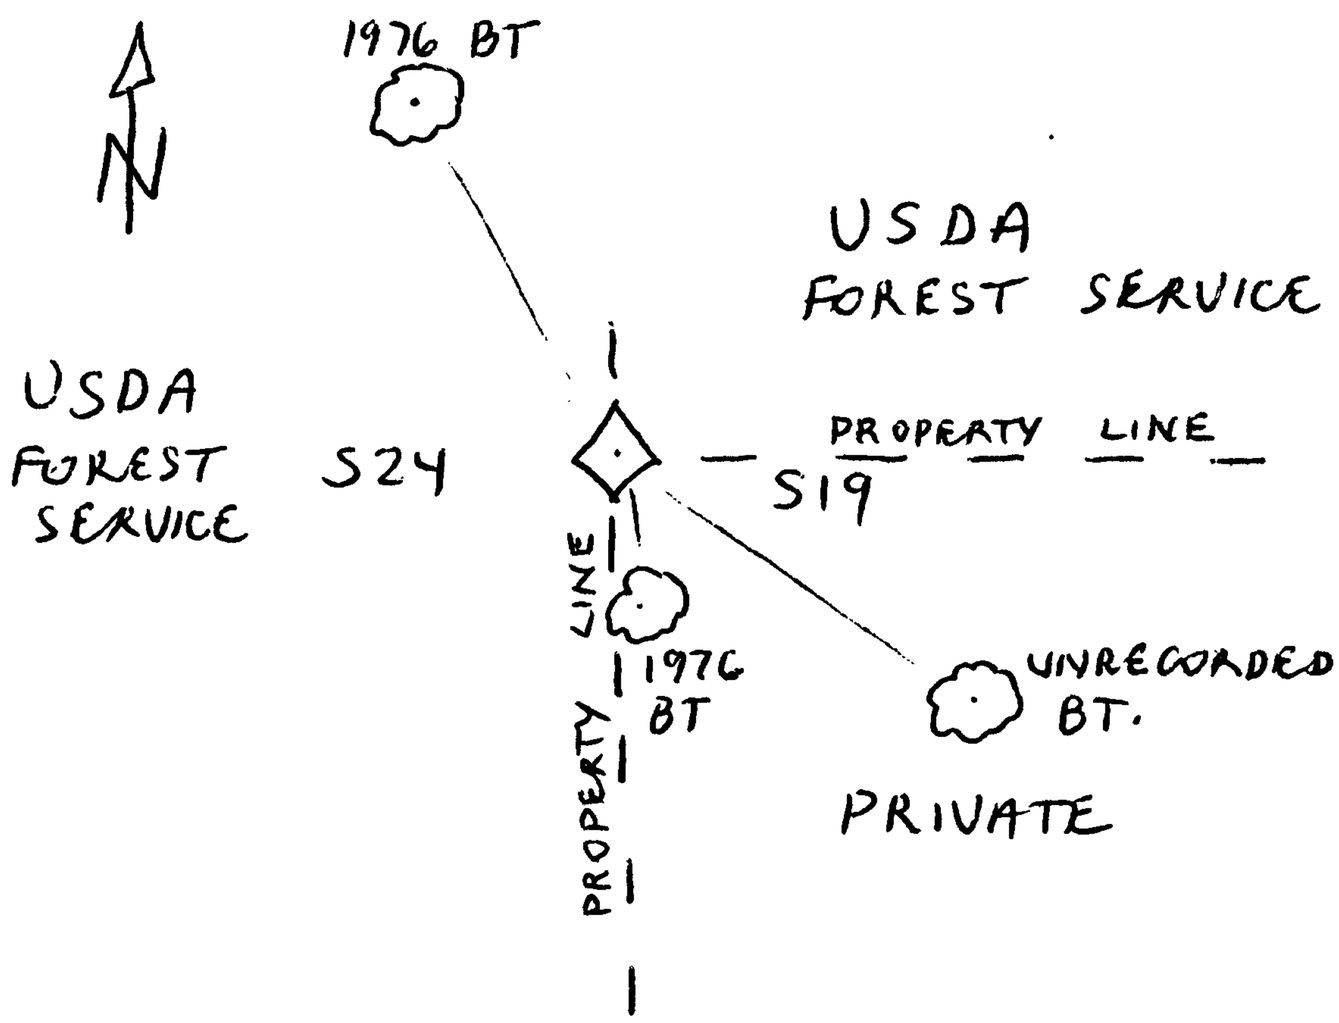

Location & Comments

Comp. Declin. 19 3/4° E
Agency FOREST SERVICE
Party Chief LEONARD HERZSTEIN
Notekeeper LEONARD HERZSTEIN
Witnesses RANDY LOPEZ

Surveyor's Seal

REGISTERED
PROFESSIONAL
LAND SURVEYOR

Maurice E Farr

OREGON
SEPT. 23, 1977
MAURICE E. FARR
1181

Aug 15, 1985