R

GOVERNMENT CORNER RESTORATION FORM

Township 25S Range 2W Sec. 20 County DOUGLAS

State OR Date 2/25/86 No.

Corner Designation

1/4 S 30 | S 29

___ Condition Report Only
___ Not Found
X Renewed
___ Unrecorded
___ Surveyed In
___ Referenced Out

Previous Renewals 1962 BLM RENEWAL

Monument(s) Found: (Condition and Source)

A BLM 3 1/4" DIA BC ON A 2 1/2" I.P. FIRMLY SET FLUSH WITH GROUND. (PER 1962 BLM REN.) POSSIBLE ORIGINAL STONE EVIDENT 2 INCHES BELOW GROUND SURFACE AT NW EDGE OF B.C. MONUMENT. WE DO NOT DISTURB MONUMENT TO EXAMINE STONE.

MONUMENT DETAIL

U.S. DEPT. OF THE INTERIOR

1/4

S30 | S29

T25S R2W

1962

BUR. OF LAND MANAGEMENT

Accessories Found:

ORIG. BTS

12" NOW 28" DIA. 50' HIGH W. FIR SNAG, WE OPENED AND FOUND SCRIBING "BT" BEARS S72 1/2°E 34.3 FT (AGREES WELL WITH 1962 BLM RENEWAL, ORIGINAL RECORD S68°E, 31 FT.)

30" NOW 42" DIA. 2 1/2 HIGH D.FIR STUMP WITH EVIDENCE OF A PARTIAL LOWER BLAZE, NO SCRIB FOUND. BEARS N55°W, 83.5' (AGREES WITH ORIG BRG, DIST. AGREES WITH 1962 BLM REN.; ORIG. REC. N55°W, 84.5 FT)

1962 BLM RENEWAL BT

15" NOW 24" DIA. 1/2 FT. HIGH D.FIR STUMP WITH A FULLY HEALED LOWER BLAZE, BEARS N15°W, 33.0 FT (AGREES WELL WITH REC.)

#120 X

C.S. File No. 62/31-6 C

RENEWAL

Monument Set (Procedure and Description)

NONE

Monument Detail

N/A

New Accessories

A DOUBLE TRUNKED O. ASH, DOUBLE BLAZED AND SCRIBED ON 11 IN. NORTH TRUNK "1/4 S29 CS BT" BEARS S 3°E, 14.5 FT.

10" DIA. R. CEDAR DOUBLE BLAZED AND SCRIBED "1/4 S30 CS BT" BEARS N 11°W, 34.9 FT.

10" DIA. MAPLE DOUBLE BLAZED AND SCRIBED "1/4 S30 CS BT" BEARS S 89°W, 13.6 FT.

Sketch of Monument, Acessories, and General Area

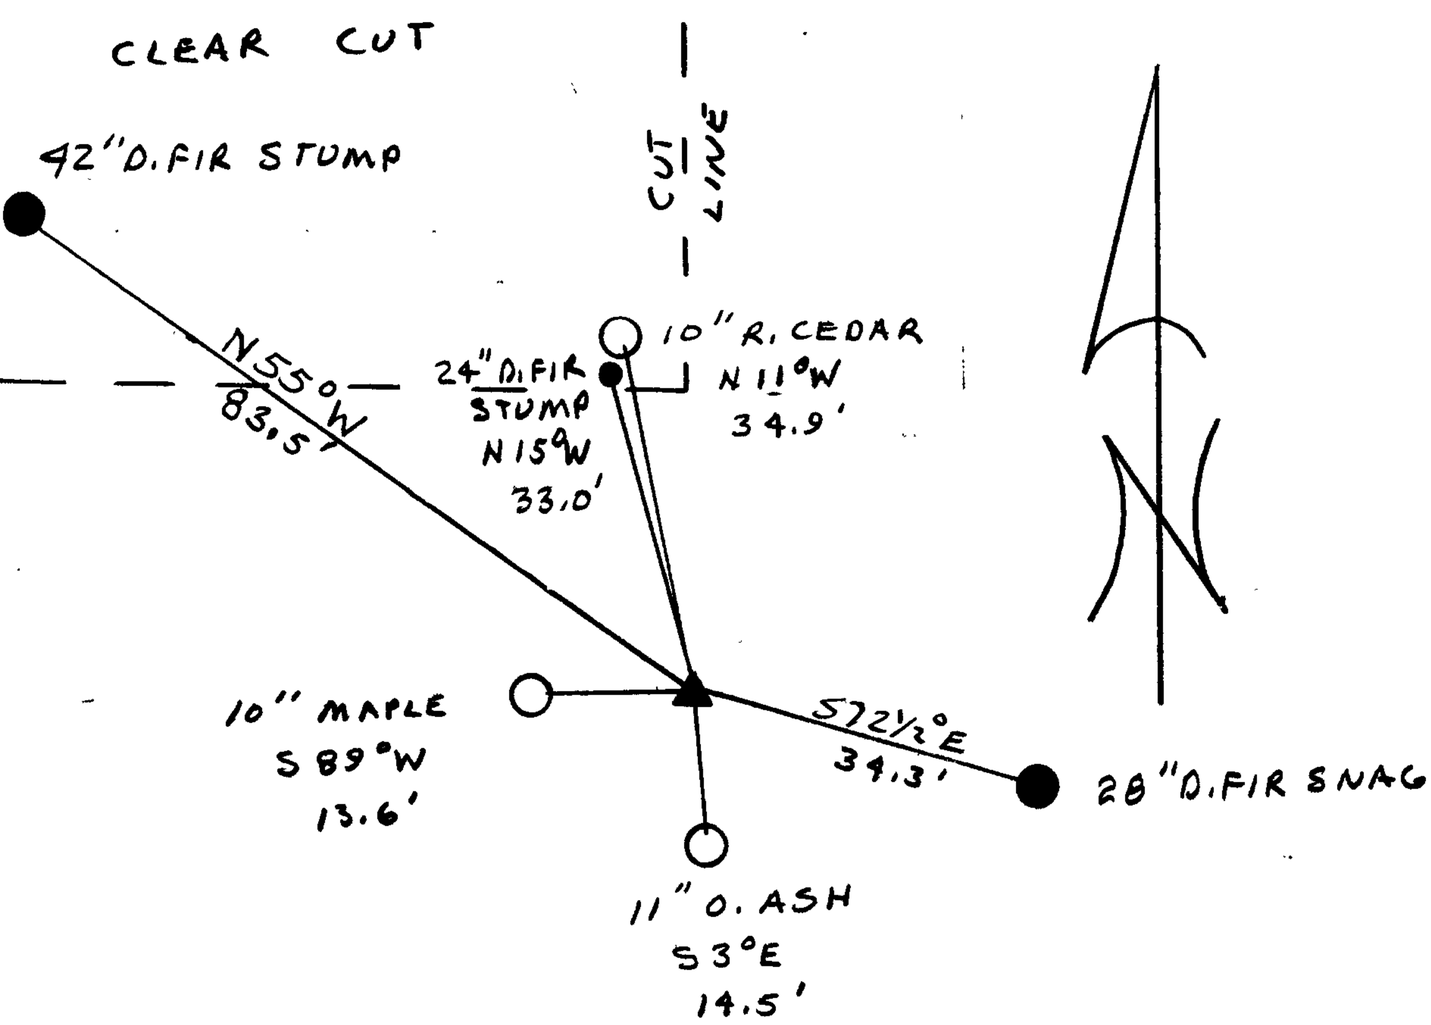

● ORIG. BT'S
• 1962 BLM REN. BT
○ NEW BT'S
▲ BC/I.P.

Location & Comments

CORNER LIES AT NORTH EDGE FLAT VALLEY BOTTOM

Comp. Declin. 18½° E
Agency DCS O
Party Chief RANDALL W SMITH
Notekeeper Randall W Smith
Witnesses STEPHEN J FLAUSE

Address

Surveyor's Seal

REGISTERED PROFESSIONAL LAND SURVEYOR

Larry E. Monrean

OREGON
JULY 13, 1979
LARRY E. MONREAN
#1830