R

GOVERNMENT CORNER RESTORATION FORM

Township 32 S Range 5W Sec. 29 County DOUGLAS

State OREGON Date APRIL 30, 1981 No.

Corner Designation

S30	S29
S31	S32

___ Condition Report Only
___/ Not Found
___√ Renewed
___ Unrecorded
___ Surveyed In
___ Referenced Out

Previous Renewals #26, THIEL 1901 RESURVEY, #12, 1964 DEPENDENT RESURVEY

Monument(s) Found: (Condition and Source)

A BLM 3 1/4 INCH DIAMETER BRASS CAP MARKED AS AT RIGHT ON A 2 1/2 INCH O.D. IRON PIPE FIRMLY SET AND PROTRUDING APPROX. 7 INCHES FROM GROUND. 3 INCHES SOUTHEAST FROM B.C. MONUMENT IS A 1 1/2 INCH DIAM. AXLE SHAFT FIRMLY SET AND PROTRUDING APPROX. 1 FOOT ABOVE GROUND.

AXLE SHAFT FROM RENEWAL #12; FOUND AND RESET WITH B.L.M. BRASS CAP IN 1964 DEPENDENT RESURVEY.

MONUMENT DETAIL

U.S. DEPT. OF THE INTERIOR

T 32 S R 5 W

S30	S29
S31	S32

1962

BUR. OF LAND MANAGEMENT

Accessories Found:

BLM BRASS CAP MONUMENT LEANS SLIGHTLY NORTH AND EAST, DISTANCES AND BEARINGS BELOW ARE MEASURED TO PLUMB POSITION.

ONE ORIGINAL BEARING TREE FOUND. A FIR, 16 INS. DIAM. NOW A ROTTED 31 INCH D.B.H., 6 FOOT TALL FIR STUMP WITH A 9 AND OTHER PARTIAL SCRIBING VISIBLE ON A PREVIOUSLY OPENED BLAZE BEARS N46°E, 16.5 FEET DISTANT AS PER RECORD. NO EVIDENCE OF OTHER ORIGINAL BEARING TREES FOUND.

ONLY ABOVE FIR FOUND FROM RENEWAL #26.

ONLY ABOVE FIR FOUND FROM 1901 RESURVEY

FROM RENEWAL #12 ABOVE ORIGINAL BEARING TREE AND FOUR RENEWAL BEARING TREES (AS FOLLOW) FOUND. A 14" CEDAR NOW A 24 INCH D.B.H RED CEDAR WITH A FULLY HEALED SINGLE BLAZE BEARS N20 1/2°E, 72.7 FEET DISTANT (AS PER RECORD). A 7" FIR, NOW A 24 INCH D.B.H., D. FIR WITH A FULLY HEALED SINGLE BLAZE BEARS S46 1/4°E, 41.8 FEET DISTANT (AS PER RECORD). A 16" ASH NOW A 19 INCH D.B.H. ASH WITH SCRIBING "32 5" VISIBLE IN AN OPENED AND PARTIALLY REHEALED SINGLE BLAZE BEARS S2.4°W, 99.4 FEET DISTANT (AS PER RECORD). AN 8" FIR NOW A 28 INCH D.B.H., D. FIR WITH A FULLY HEALED SINGLE BLAZE BEARS S88°W, 12.6 FEET DISTANT (RECORD S88°W, 12.0 FT POSSIBLE FACE MEAS.)

FROM BLM 1964 DEPENDENT RESURVEY FOUR BEARING TREES FOUND (CONTD ON BACK)

#221

C.S. File No. 62/45-23C

RENEWAL

ACCESSORIES FOUND CONT'D.

~~Monument Detail (Remarks and Description)~~

A FIR, 8 INS. DIAM. NOW A 17 INCH D.B.H. DOUGLAS FIR WITH A FULLY HEALED SINGLE BLAZE BEARS N29°E, 21.8 FEET DISTANT (AS PER RECORD). A FIR, 14 INS. DIAM. NOW A 21 INCH D.B.H. DOUGLAS FIR WITH A FULLY HEALED SINGLE BLAZE BEARS S15°E, 31.0 FEET DISTANT (AS PER RECORD). A FIR, 8 INS DIAM. NOW AN 18 INCH D.B.H. DOUGLAS FIR WITH A FULLY HEALED SINGLE BLAZE BEARS S12°W, 25.1 FEET DISTANT (AS PER RECORD). AND A FIR, 15 INS. DIAM NOW A 27 INCH D.B.H. DOUGLAS FIR WITH A FULLY HEALED SINGLE BLAZE BEARS N33°W, 52.8 FEET DISTANT (AS PER RECORD)

~~Monument Detail~~

NA

New Accessories

NONE

Sketch of Monument, Acessories, and General Area

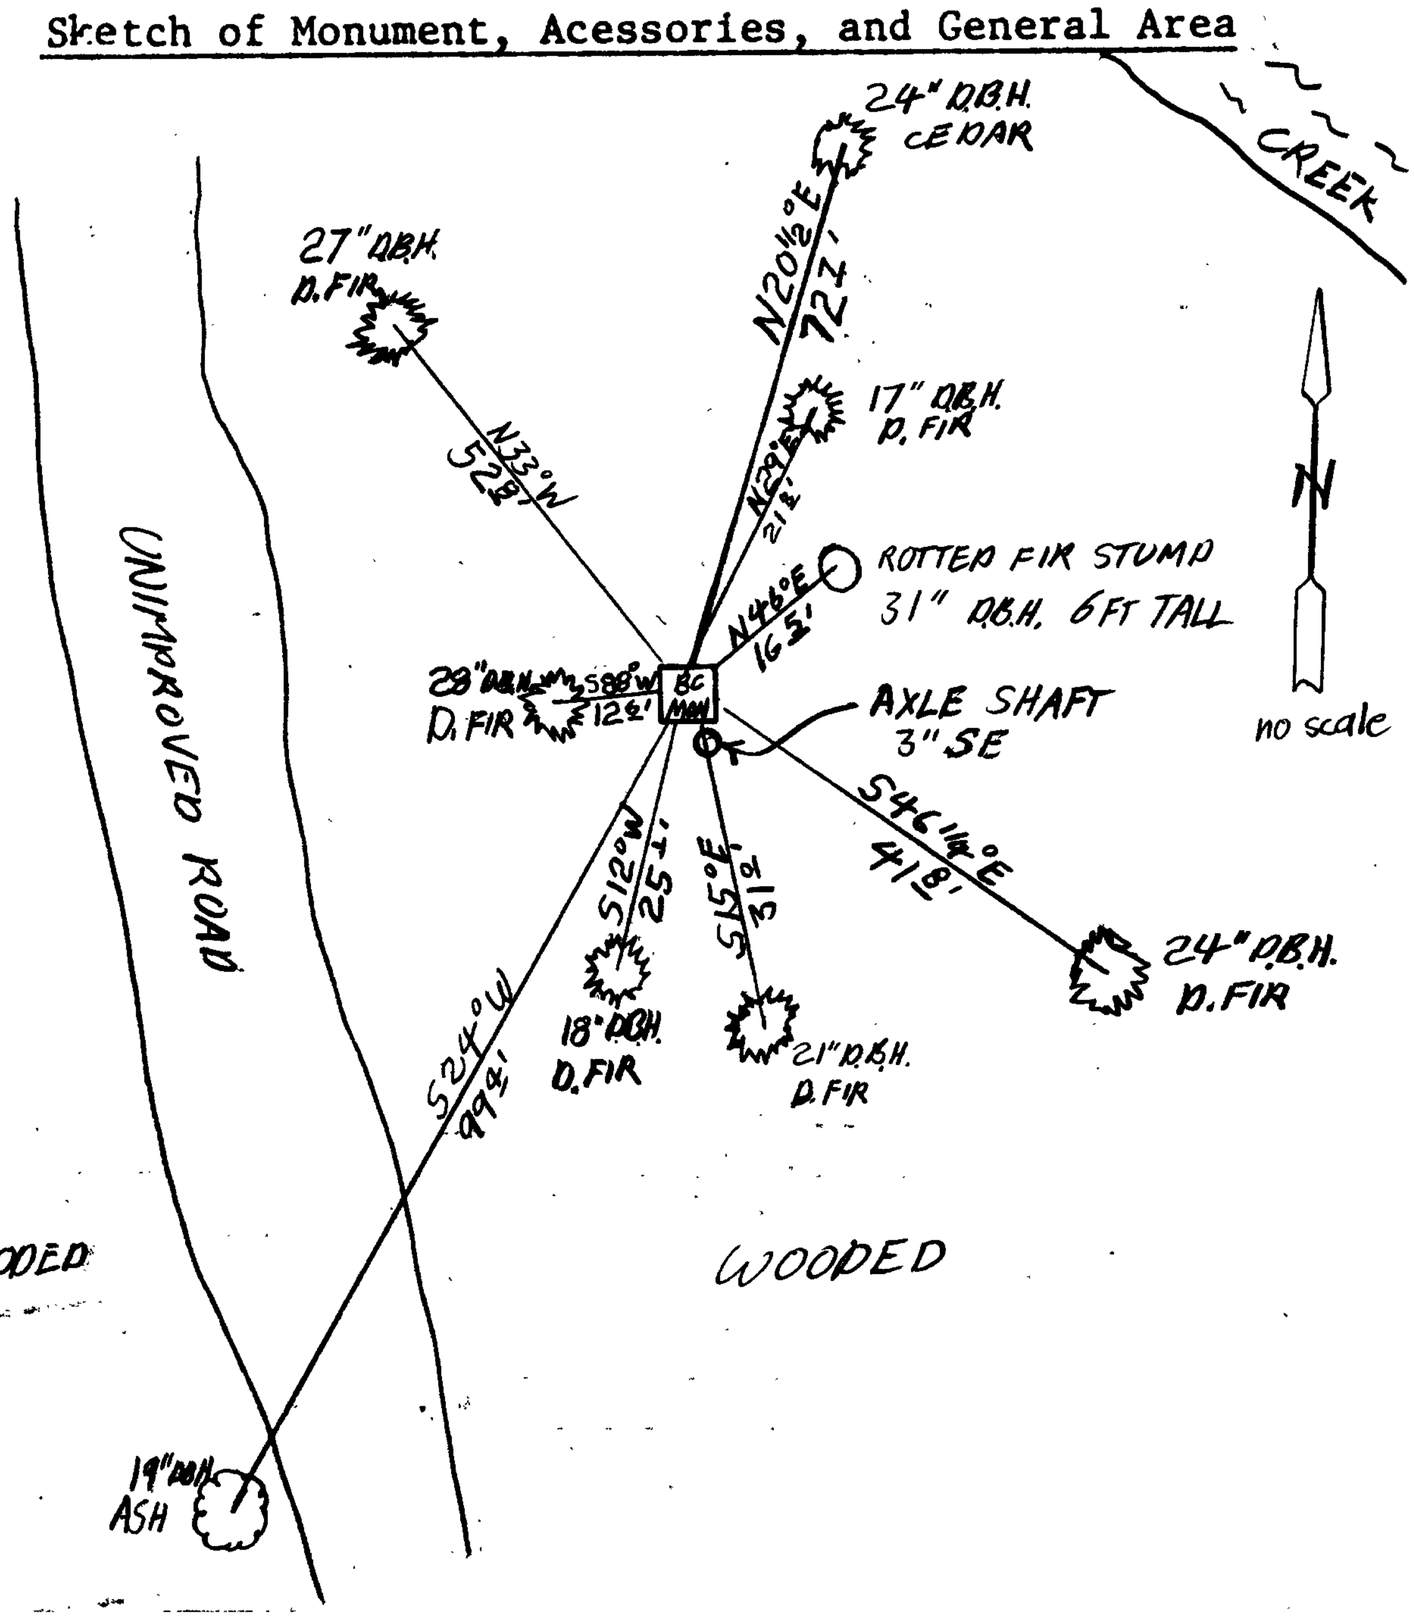

Location & Comments

MONUMENT IS JUST EAST OF A ROAD RUNNING ON WEST SIDE OF WOODFORD CREEK AND IS APPROXIMATELY 300 FT SOUTH OF A PRIVATE RESIDENCE.

SEE ALSO M 101-16

Comp. Declin. 18 1/2°E
Agency DCSO
Party Chief STEPHEN JOHN ELAUSE
Notekeeper Stephen John Elause
Witnesses R.W. SMITH

Address

Surveyor's Seal

REGISTERED PROFESSIONAL LAND SURVEYOR

Larry E. Mo

OREGON
JULY 13, 1979
LARRY E. MONREAN
#1830