R

GOVERNMENT CORNER RESTORATION FORM

Township 25S Range 6W Sec. 8 County DOUGLAS

State OREGON Date 9/9/88 No.

Corner Designation

1/4

S8 | S9

___ Condition Report Only
___ Not Found
✓ Renewed
___ Unrecorded
___ Surveyed In
___ Referenced Out

Previous Renewals VOL 2, PG 157, #64

Monument(s) Found: (Condition and Source)

A 2 1/2 INCH DIAMETER BRASS CAP (MARKED AS AT RIGHT) ON A 1 1/4 INCH O.D. IRON PIPE, FIRMLY SET, AND PROTRUDING APPROXIMATELY 14 INCHES ABOVE GROUND. MONUMENT LIES IN N-S FENCELINE B.C. MONUMENT FROM RENEWAL #64.

FOUND POSSIBLE GERMOND FOUND STONE (VOL 2, PG 157) 8X8X3 1/2 INCH AND STONE FRAGMENTS (ORIGINAL SIZE 2X8X16 INCH) BEARING N 36° E, 2Q FEET FROM FOUND BRASS CAP. TOP OF STONE 3 INCHES BELOW GROUND.

MONUMENT DETAIL

COUNTY SURVEYORS OFFICE

1/4 S 8 | S 9

T25S R6W

1958

Accessories Found:

ORIGINAL SW BEARING TREE NOT FOUND. POSSIBLE EVIDENCE OF ORIGINAL SE 11 INS. V. OAK BEARING TREE FOUND. A ROTTED 2 FOOT TALL 18 INCH DIAMETER OAK STUMP PREVIOUSLY OPENED BUT SHOWING NO SCRIBING BEARS S 39 1/2° E, 21 FEET DISTANT AT CENTER OF ROOT CROWN (RECORD S 34 1/2° E, 19Q FEET DIS. DISTANCE IS POSSIBLE FACE MEASUREMENT).

GERMOND (VOL. 2, PG 157) RENEWAL TREE A 40" OAK NOW A 4 FOOT 30 INCH DIAMETER ROTTED OAK STUMP WITH A PREVIOUSLY OPENED BLAZE, NO SCRIBING FOUND, REMOVED FROM ORIGINAL POSITION BY ROADWORK BEARS S 02° E, 17Q FEET DIST. (RECORD S 26 1/2° W, 35')

TWO RENEWAL BEARING TREES, RENEWAL #64 FOUND. A 12" R. FIR NOW A 26 INCH D.B.H. DOUGLAS FIR WITH A FULLY HEALED DOUBLE BLAZE BEARS N 8 1/2° E, 21Q FEET DISTANT (AS PER RECORD). AN 8" W. OAK NOW A 13 INCH D.B.H. WHITE OAK WITH A FULLY HEALED DOUBLE BLAZE BEARS N 68 1/2° W, 60 3/Q FEET DISTANT (AS PER RECORD).

#1914

C.S. File No. 62/55-2 C

RENEWAL

Monument Set (Procedure and Description)

NONE

Monument Detail

N/A

New Accessories

A 6 INCH D.B.H. WHITE OAK DOUBLE BLAZED AND SCRIBED "1/4 S 9 CS BT" BEARS S 72 1/2° E, 13 ¼ FEET DISTANT.

A 9 INCH D.B.H. DOUGLAS FIR DOUBLE BLAZED AND SCRIBED "1/4 S8 CS BT" BEARS S55°W, 33 ½ FEET DISTANT.

Sketch of Monument, Acessories, and General Area

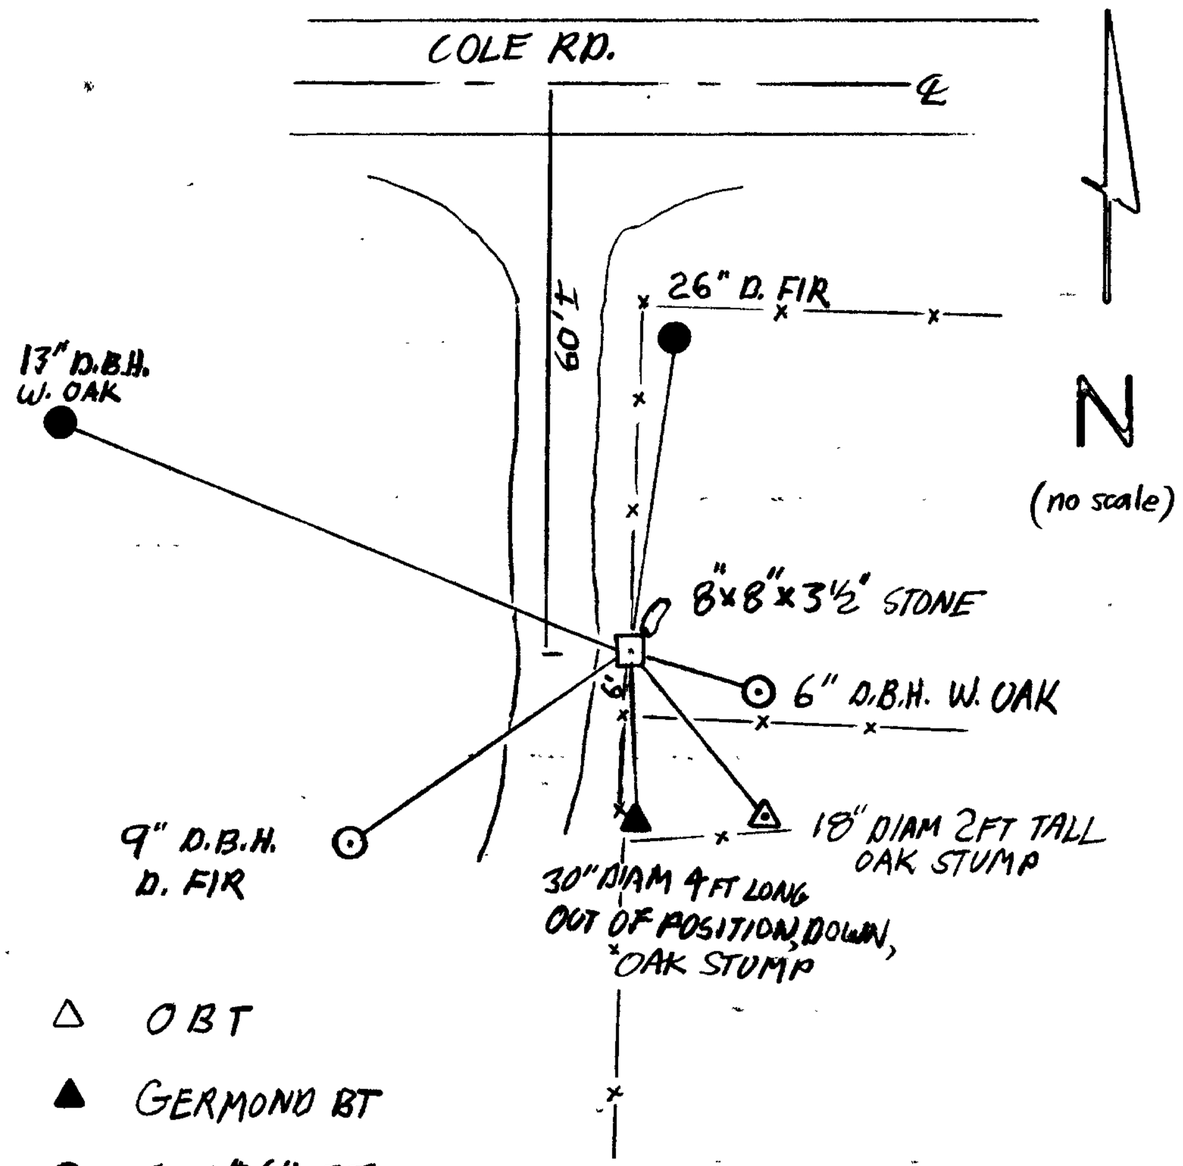

Location & Comments

MONUMENT LIES IN N/S FENCELINE AT EASTERLY EDGE OF FARM ACCESS ROAD AND APPROXIMATELY 60 FEET SOUTH FROM ℄ OF COLE ROAD (DOUG. CO. RD. #91).

Comp. Declin. 18 ½° E
Agency DCSD
Party Chief R.W. SMITH
Notekeeper STEPHEN JOHN FLAUSE
Witnesses Stephen John Flause

Address

Surveyor's Seal

REGISTERED
PROFESSIONAL
LAND SURVEYOR

Larry E. Monrean

OREGON
JULY 13, 1979
LARRY E. MONREAN
#1830