R

GOVERNMENT CORNER RESTORATION FORM

Township 28S Range 2W Sec. 14 County DOUGLAS

State OREGON Date 9/6/88 No.

Corner Designation

1/4 S14 / S23

____Condition Report Only
____Not Found
__✓__Renewed
____Unrecorded
____Surveyed In
____Referenced Out

Previous Renewals #46

Monument(s) Found: (Condition and Source)

A GLO DISK 2 1/2 INCHES IN DIAMETER (MARKED AS AT RIGHT) ON A 1 INCH O.D. IRON PIPE PROTRUDING 12 INCHES ABOVE GROUND AND LEANING 8 INCHES WEST OF PLUMB.

MONUMENT DETAIL

U.S. GENERAL LAND OFFICE SURVEY

1/4 S14 / S23

1923

Accessories Found:

BEARINGS AND DISTANCES TAKEN TO PLUMB POSITION OF BC/IP

22" NOW 22 DIA. 14 IN. HIGH ROTTED FIR STUMP WITH A FULLY HEALED LOWER BLAZE, BLAZE OPENER AND ILLEGIBLE SCRIBING FOUND, BEARS N 20°E, 29.7 FT (AGREES WITH RECORD) ORIG. BT

10" NOW 13" DIA DOWN HEMLOCK WITH A FULLY HEALED BLAZE, BEARS S 20°W 18.5 FT. TO CENTER OF REMAINING ROOT CROWN (AGREES WITH RECORD) ORIG. BT.

TWO TREES FROM RENEWAL #46 FOUND.
AN 8" HEMLOCK NOW AN 8 INCH DIAMETER FALLEN SOUTH WESTERLY AND BROKEN, DEAD HEMLOCK WITH A PARTIALLY HEALED SINGLE BLAZE WITH SCRIBING 1/4 S23 CS BT VISIBLE; HAS STUMP HOLE BEARING S 67°W, 9.8 FT. (AGREES WITH RECORD).

A 10" D. FIR NOW MEASURING 9 INCHES D.B.H AND NOW A DEAD 35 FOOT TALL SNAG WITH THE SCRIBING 1/4 S14 CS BT VISIBLE ON A PARTIALLY HEALED SINGLE BLAZE BEARS N 23°W, 6.7 FEET (AS PER RECORD) TO CENTER OF TRUNK ABOVE BLAZE AND N 16 1/2°W, 6.7 FEET TO CENTER OF ROOT CROWN.

#145+

C.S. File No. 62/55-6C

RENEWAL

Monument Set (Procedure and Description)

MONUMENT IS STRAIGHTENED TO PLUMB POSITION AND IS NOW FIRMLY SET PROTRUDING 10 INCHES ABOVE GROUND.

Monument Detail

New Accessories

TWO NEW BEARING TREES. A 6 INCH D.B.H. HEMLOCK DOUBLE BLAZED AND SCRIBED 1/4 S 23 CS BT BEARS S 71 1/2°W, 88 5 FEET DISTANT. A 6 INCH D.B.H. HEMLOCK DOUBLE BLAZED AND SCRIBED 1/4 S 23 CS BT BEARS S 06°W, 113± FEET DISTANT.

TWO BEARING OBJECTS SET. A BOAT SPIKE STAMPED B 0 1 SET THROUGH A BEARING TREE TAG AT THE CENTER OF A 48 INCH DIAMETER 18 INCH HIGH D. FIR STUMP BEARS N 82 1/2°E, 19 6 FEET DISTANT. A BOAT SPIKE STAMPED B 0 2 SET THROUGH A BEARING TREE TAG AT THE CENTER OF A 24 INCH DIAMETER 1 FOOT HIGH D. FIR STUMP BEARS N 32 1/2°W, 62 9 FEET DISTANT.

Sketch of Monument, Acessories, and General Area

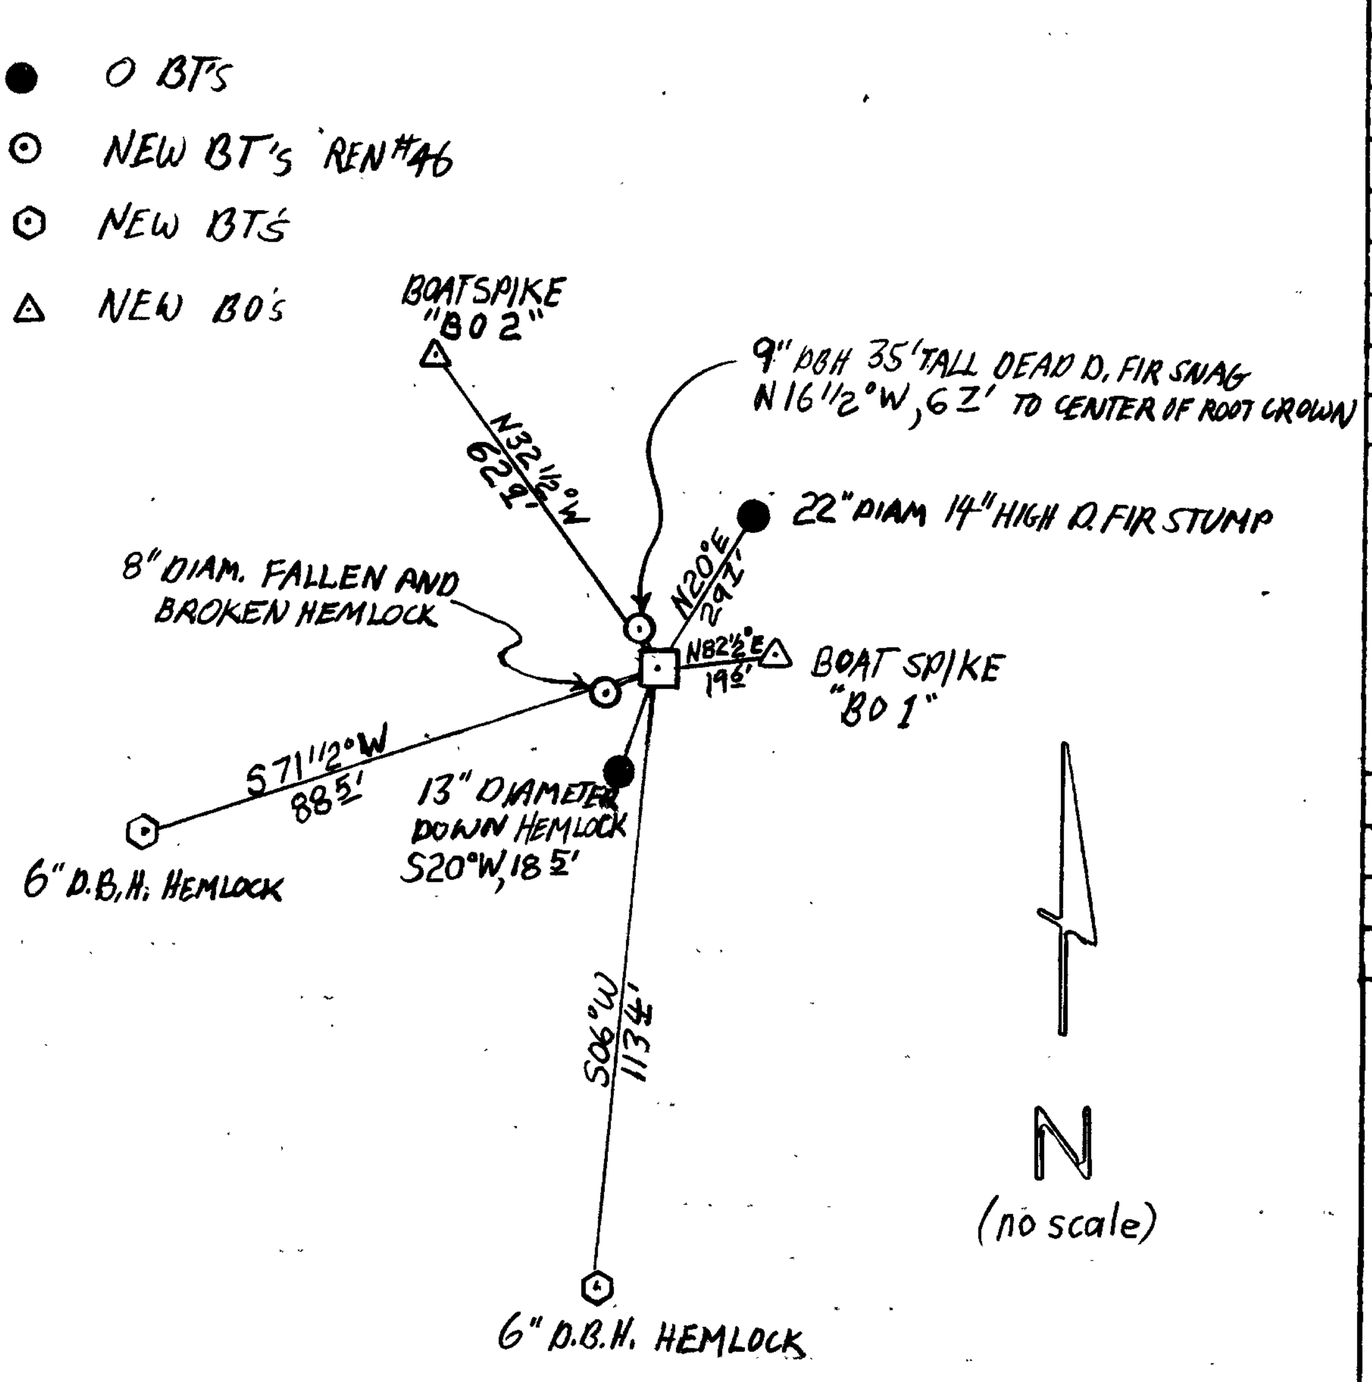

Location & Comments

MONUMENT IS IN A CLEARCUT AND APPROXIMATELY 400 FEET WEST FROM A LINE CROSSING TAG ON A G. FIR AT THE EAST EDGE OF USFS RD. 780.

Comp. Declin. 18° E
Agency OCSO
Party Chief R. W. SMITH
Notekeeper Stephen John Flause
Witnesses S. J. FLAUSE

Address

Surveyor's Seal

REGISTERED PROFESSIONAL LAND SURVEYOR

Larry E. Mon

OREGON
JULY 13, 1979
LARRY E. MONREAN
#1830