R

FILED

MAY 17 1989

COUNTY SURVEYOR
DOUGLAS COUNTY, ORE.

# GOVERNMENT CORNER RESTORATION FORM

Township 24 S. Range 4 W Sec. 17 County DOUGLAS

State OR. Date 5-17-89 No.

Corner Designation

NE COR. DLC 40

____ Condition Report Only
____ Not Found
X Renewed
____ Unrecorded
____ Surveyed In
____ Referenced Out

Previous Renewals #90

Monument(s) Found: (Condition and Source)

1963 1 3/8" DIAM. IRON PIPE WITH 2 1/2" DIAM BRASS CAP PROTRUDING 9" ABOVE GROUND. CAP IS PROPERLY MARKED - MONUMENT IS FIRMLY SET.

MONUMENT DETAIL

COUNTY SURVEYORS OFFICE
T 24 S R 4 W
N.E. DLC 40
1963

Accessories Found:

ORIGINAL: 24" B. OAK NOW DOWN & DECAYED 27" DIAM WITH PREVIOUSLY OPENED BLAZE AND DECAYED FACE NO SCRIBING VISIBLE. BEARS S 25°W 19.8 FT TO DEPRESSION IN GROUND.

20 30" D. OAK NOW A 30 FT. HIGH 34" DIAM SNAG WITH HEALED SCAR BEARS N 65°W 16.5 FT.

REN. #90: 15" NOW 17" DIA. MAPLE WITH HEALED BLAZE BEARS N 15°W 48.0 FT.

12" NOW 28" DIA. FIR WITH HEALED BLAZE BEARS S 56°E ~~53.7~~ 52.5 FT (REC. 53.6 FT.)

#174

G.S. FILE NO. 62/63-15 C

RENEWAL

Monument Set (Procedure and Description)

NONE

Monument Detail

N/A

New Accessories

13" MADRONE BARK SCRIBED "NE DLC 40 CS BT" BEARS N 87°W 19.3 FT.

10" NORTHERLY TRUNK OF FORKED MAPLE DOUBLE BLAZED AND SCRIBED "NE DLC 40 CS BT" BEARS N 67°E 16.2 FT. TO CENTER OF ROOT CROWN.

Sketch of Monument, Acessories, and General Area

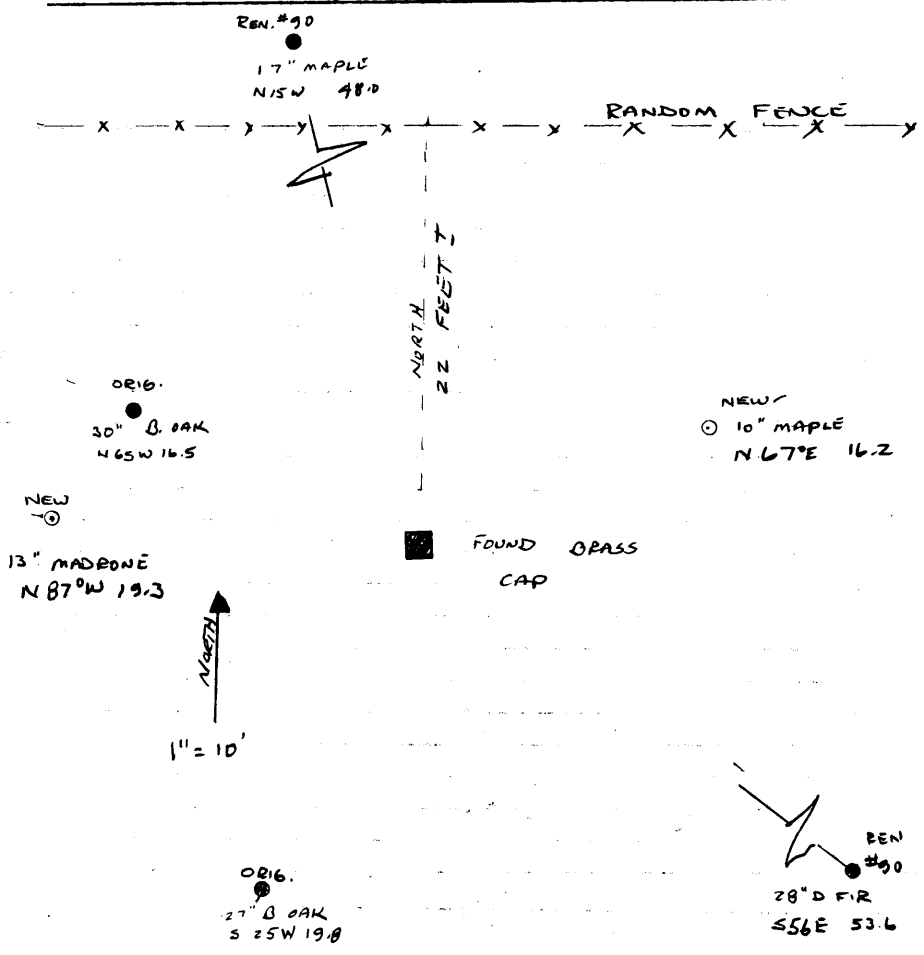


Location & Comments

Comp. Declin. 18° EAST
Agency DOUGLAS COUNTY SURVEYOR'S OFFICE
Party Chief L. MONREAN
Notekeeper [signature]
Witnesses R. W. SMITH

Address Rm 205 JUSTICE BLDG.
ROSEBURG, OR. 97470

Surveyor's Seal

REGISTERED PROFESSIONAL LAND SURVEYOR

[signature]

OREGON
JULY 13, 1979
LARRY E. MONREAN
#1830